

CODED

UNION
G 66
6-25-73

MISSISSIPPI
BOARD OF WATER COMMISSIONERS
416 North State Street
Jackson, Mississippi 39201

WATER WELL DRILLERS LOG

June 25 1973 Ed Clark Union
date well completed firm name county well located

LANDOWNER:

James Beard
Rt 4 - New Albany
(mailing address)

description of formations encountered

description of formations encountered	from	to
Shale	0	30
Blue mud	30	100
Red & Sand	100	150
Blue mud	150	175
Red & Sand	175	220

WELL LOCATION:

sec 36 T 7 N R 2 E
8 miles S of New Albany
(distance) (direction) (nearest town)

WELL PURPOSE:

None
(home, irrigation, municipal, industrial)

WELL COMPLETION DATA:

- (1) diameter (inches) 4"
- (2) total depth (feet) 220'
- (3) static water level (feet) 20' below top of ground.
- (4) casing Metal, 82' (material) (depth)
4" (size) if telescope see back.
- (5) screen None (length) (depth to top)
(size) (material)
- (6) pump 1 1/2 (HP) 8 (yield gpm)
Electric (type power)
- (7) electric log no (yes or no)
(organization running log)
- (8) how well bottom plugged


CODED

JUL 25 1973

DRILLERS REMARKS:

If well telescopes please sketch and show depths.

GROUND LEVEL

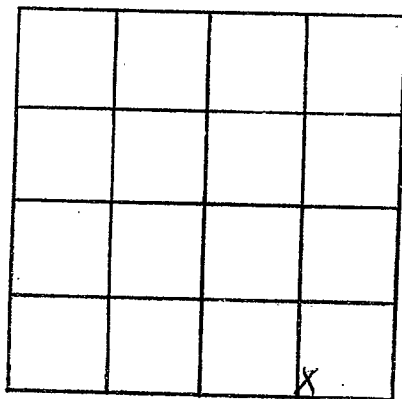

SECTION _____

Please indicate well location X.

ADDITIONAL INFORMATION

If more than one screen,
show locations of each on sketch.