

UNION
G 69
9-8-73

MISSISSIPPI
 BOARD OF WATER COMMISSIONERS
 416 North State Street
 Jackson, Mississippi 39201

CODED

WATER WELL DRILLERS LOG

9-8-

1973

Leepul Drilling Co.

Union

date well completed

firm name

county well located

LANDOWNER:

Charles L. Parks
 Rt. Myrtle, Miss
 (mailing address)

description of formations encountered

from to

Red Clay	0	20
Red Clay + sand	20	40
Blue Clay + Rock	40	120
Blue Clay + sand	120	160
streambed		
Rock	160	230

WELL LOCATION:

sec. 5 T. 7 S. R. 2 E.

_____ miles _____ of _____
 (distance) (direction) (nearest town)

WELL PURPOSE: Home
 (home, irrigation, municipal, industrial)

WELL COMPLETION DATA:

(1) diameter (inches) 4
 (2) total depth (feet) 230
 (3) static water level (feet) 80 below above
 top of ground

(4) casing steel
 (material) (depth)

_____ if telescope see back.
 (size)

(5) screen none
 (length) (depth to top)

_____ (size) _____ (material)

(6) pump 3/4 10
 (HP) (yield gpm)

Elect
 (type power)

(7) electric log no
 (yes or no)

_____ (organization running log)

(8) how well bottom plugged open

CODED


DRILLERS REMARKS:

3 19/73

MISS. BD.
 WATER

If well telescopes please sketch and show depths.

GROUND LEVEL

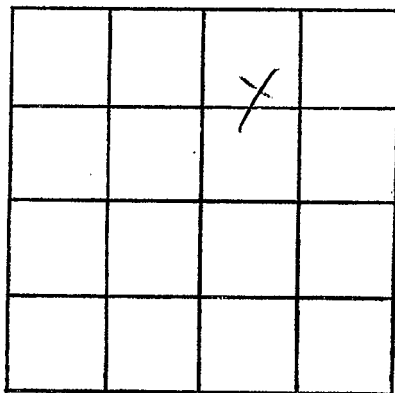

SECTION 5

Please indicate well location X.

ADDITIONAL INFORMATION

A series of horizontal lines for writing additional information.

If more than one screen, show locations of each on sketch.