

Union
G 71
6-28-75

MISSISSIPPI
BOARD OF WATER COMMISSIONERS
416 North State Street
Jackson, Mississippi 39201

850.00
TAX 42.50

WATER WELL DRILLERS LOG

CODED
UNION

6 28 1975 date well completed
J T Medlin firm name
UNION county well located

LANDOWNER:	description of formations encountered	from	to
G. B. Starnes Pookville			
	Sand	8	35
	Clay	35	110
(mailing address)	Rock Sand	110	300

WELL LOCATION:
sec. 19 T 4 N R 2 E
2 miles S of Pookville
(distance) (direction) (nearest town)

WELL PURPOSE:
(home, irrigation, municipal, industrial)


- WELL COMPLETION DATA:
- (1) diameter (inches) 4
 - (2) total depth (feet) 300
 - (3) static water level (feet) 14 below top of ground.
 - (4) casing P 90 (material) (depth)
 - (size) if telescope see back.
 - (5) screen (length) (depth to top)
 - (size) (material)
 - (6) pump 12 10 (HP) (yield gpm)
 - (type power)
 - (7) electric log (yes or no)
 - (organization running log)
 - (8) how well bottom plugged

DRILLERS REMARKS:

RECEIVED
JUL - 9 1975

If well telescopes please sketch and show depths.

GROUND LEVEL

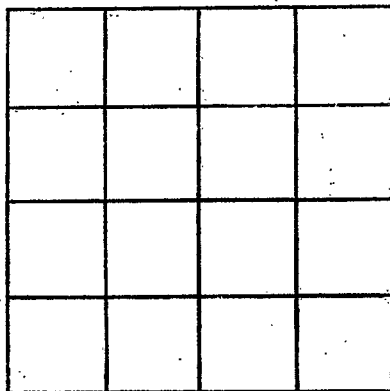

SECTION _____

Please indicate well location X.

ADDITIONAL INFORMATION

If more than one screen,
show locations of each on sketch.