

UNION  
G 72  
9-3-75

MISSISSIPPI  
BOARD OF WATER COMMISSIONERS  
416 North State Street  
Jackson, Mississippi 39201

15F

WATER WELL DRILLERS LOG

CODED

Sept. 3, 1975 W.E.D. Union  
date well completed firm name county well located  
J.P. Heddlum

LANDOWNER:  
C.O. Brewer  
Highway 30 West New Orleans  
(mailing address)

description of formations encountered from to

WELL LOCATION:  
sec. 10-70 R 23E S  
(distance) miles (direction) of (nearest town)

100 ft. casing

WELL PURPOSE:  
(Home, irrigation, municipal, industrial)

250 ft. deep  
Clay

WELL COMPLETION DATA:

0 160  
Rocky clay 160 190

(1) diameter (inches) 4

Blue Clay 190 210

(2) total depth (feet) 260

1/2" + sand 210 260

(3) static water level (feet) 210 below above top of ground.

(4) casing 100 (material) (depth)  
if telescope see back.

(5) screen (length) (depth to top)

(size) (material)

(6) pump 1/2 (HP) 700 (yield gpm)

Electric (type power)

(7) electric log (yes or no)

(organization running log)

(8) how well bottom plugged

Highway 30 South  
turn at Brewer's  
store on right.


DRILLERS REMARKS:

MISSISSIPPI  
BOARD OF WATER COMMISSIONERS  
OCT 20 1975

MISS. BD. OF WATER COMMISSIONERS

If well telescopes please  
sketch and show depths.

GROUND LEVEL

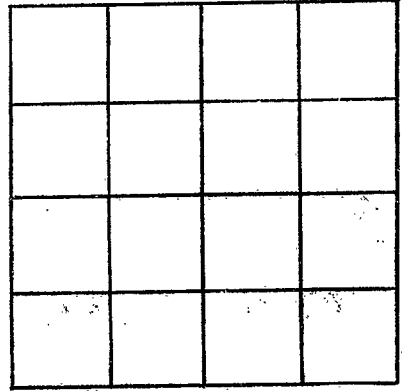

SECTION \_\_\_\_\_

Please indicate well location X.

ADDITIONAL INFORMATION

If more than one screen,  
show locations of each on sketch.