1	Well Report	For Office Use Only:	
	Part 1 – Driller's Log		
Mississippi Departing	Mississippi Department of Environmental Quarty		
1 "Z1 A Z . 1	Office of Land and Water Resources		
Dan IDAVE STIANUE	Office of Land and Water Resources P.O. Box 10631 Jackson, MS 39289-0631 L. S. Elevation:		
, , , , , , , , , , , , , , , , , , ,	Jackson, MS 39289-0631		
Date di limit compresse.	(601)961-5210 (601)354-6938 (fax)		
(001)3	34-0938 (1ax)	E-log #:	
State Law requires that this report be prepared by the license holder responsible for the work and filed with the Department at the above address within 30 days of completion of drilling of the well or borehole.			
Information on Well Owner	Well or Bo	rehole Location	
(Landowner if borehole is not for a water well)	24 020 20	" I anathyday 89 000 107"	
10001 Minachano	Latitude: 34 50 Uk	" Longitude: 87 ° 04 ' 07"	
mer Name LARRY MURPHREO Method of Lat/Long (circle of		e): Conventional Survey,	
Mailing Address: 1098 CR 64N	USGS quad, Hand-held	GPS, Survey-grade GPS	
New Albany, MS 38652	Www. Sw/4 Sec 2	Twn 75 Rng 3 E	
City State Zip Code	Distance Direction	Nearest Town of New Albory	
Telephone No. (<u>662)</u> 266 - 2008	Times	1100 1100	
Well / Bor	ehole Data		
Date drilling started: 5/3/10 Date drilling completed: 5/5/10 Hole depth: 263 Hole diameter: 8"			
Location of the source of any surface water used for drilling: Method of dosing and volume of Chlorine used in drilling and development:			
Logs run (circle all applicable): No log run Electric Gamma Ray Density Sonic Neutron Other:			
Purpose of borehole (check one): Water Well Geotechnical/Geological Investigation Ground Source Heat Pump			
Seismic Survey Other (describe)			
· · · · · · · · · · · · · · · · · · ·			
Purpose of Well (check one): HomeIndustrialPublic SupplyIrrigationFish CultureOther:			
If a flowing well, method of flow regulation: Valve Other (describe)			
Static Water Level: 142 feet above or below (circle one) land surface Date measured: 5/5//0			
Method of Measurement (circle one) steel tape electric tape air line other:			
Well depth: 263 Well grouted to a depth of 20 feet Type of grout (circle one) Neat Cement Bentonite Mix			
Casing length: 203 feet Casing diameter: 4 inches Type of casing: PVC Screen length: 60 feet Screen diameter: 4 inches Type of screen: PVC			
Screen length: 60 feet Screen diameter:	inches Type of screen:	<i>'VC</i>	

Setting depth: From 203

Other (describe):

Top of lau BY: OLVR

Screen slot size: inches

Type of completion (circle all applicable). Gravel packed Underreamed

Form: OLWR-SWR-1A

feet

Natural Development

____feet to <u>263</u>

Telescoped Open hole

feet. If telescoped or more than one screen, describe on next page

STATE WELL REPORT

Part 2

County: Permit #: Driller: Date completed:

Test Pumping Rate: 60 Gallons Per Minute

Duration of Pump Test (minimum 4 hours): _______hours

Pump Installer's Completion Report Mississippi Department of Environmental Quality Office of Land and Water Resources P.O. Box 10631 Jackson, MS 39289-0631

(601)961-5210 (601)354-6938 (fax)

For Office Use Only:		
Aquifer:		
Well #: 6 94		
Elevation:		

Copy information from block on Part 1 This part of the report must be completed by a licensed water well contractor or a licensed pump installer. A copy of Part 1 of the report must be attached and both parts filed with the Department at the above address within 30 days of well completion. Well Owner Information Well Location Owner Name: LARRY MURPhaco Latitude: Longitude: Mailing Address: 1098 CR 64W Method of Lat/Long (check one): Conventional Survey____, New Albany, MS. 38652 USGS quad_____, Hand-held GPS____, Survey-grade GPS____ NW 1/ SW 1/ Sec 2 T 7/5 R.3/E Zip Code City State Direction Distance ___ Miles Ext of New Albany Telephone No. (66) 266 - 2008 Pump Type Power Type Circle one Circle one Diesel Engine Gasoline Engine Natural Gas Air Lift Jet Submersible Hand Tractor PTO Bucket Piston Turbine Electric Motor Windmill Other (specify): Centrifugal Rotary Flowing Well Horse Power Rating of Motor: SHP Other (specify): Setting Depth: 210 Rated Pump Capacity: 60 Number of Stages: 26 Gallons Per Minute Pump Test Data Method of Measuring Water Level Circle one Date Well Tested: \$/5//0 Electric Measuring Line Air Line Steel Tape Static Water Level (A): /// Feet Below Land Surface Other (specify): _ Pumping Water Level (B): 186 Feet Below Land Surface For flowing well, measured shut in head: _____feet Drawdown [(B) - (A)]: 44 Feet Below Land Surface

I HEREBY CERTIFY that the above statements are true to the b	est of my knowledge.
	Talu Fa
LANDURN PARKS	Maybundan
Print Name of Pump Installer and License No. (if applicable)	Signature Pump Installer


Form: OLWR-SWR-1B

Well yielded GPM with a drawdown of

feet after hours of pumping

If well telescopes, show depths on sketch. Ground Level_ Description of Formations Encountered From (depth) To (depth) Ground Level COMENT 10 200-4" CASING 60'- 012 SCROON

If more than one screen, show location of each on sketch

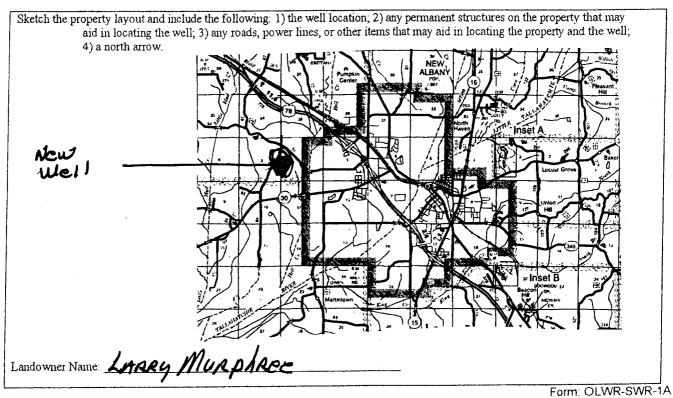

I certify that the well/borehole was drilled, constructed, and completed in accordance with all applicable requirements of the Mississippi Department of Environmental Quality and the Mississippi Department of Health regulations, if applicable, and state

Print Name of Responsible Licensee and License No.