

UNION  
 G 2000  
 8-20-75

MISSISSIPPI  
 BOARD OF WATER COMMISSIONERS  
 416 North State Street  
 Jackson, Mississippi 39201

WATER WELL DRILLERS LOG

Aug 20 1975 J. W. Whitson Union  
 date well completed firm name county well located

LANDOWNER: Junior Bunks  
 new Albany

description of formations encountered	from	to
Soil	0	1
Mudstone	1	38
Top Blue Rock	38	50
Blue Rock	50	110
Shale & Sand	110	125
Blue Rock	125	175
Water Rock	175	180
Sand & Rocks	180	260

(mailing address)  
 WELL LOCATION:  
 sec. 10 T. 7 N R. 2 E 15F  
 3 miles west of new Albany  
 (distance) (direction) (nearest town)

WELL PURPOSE:  
 (home, irrigation, municipal, industrial)

- WELL COMPLETION DATA:
- (1) diameter (inches) 4
  - (2) total depth (feet) 260
  - (3) static water level (feet) 44 below above top of ground.
  - (4) casing Steel, 63  
 (material) (depth)  
4" if telescope see back.  
 (size)
  - (5) screen 0 / 0  
 (length) (depth to top)  
 (size) (material)
  - (6) pump 1 1/2 HP / 4  
 (HP) (yield gpm)  
Elec  
 (type power)
  - (7) electric log \_\_\_\_\_  
 (yes or no)  
 (organization running log)
  - (8) how well bottom plugged \_\_\_\_\_


DRILLERS REMARKS:

NOV 21 1975

MISSISSIPPI BOARD OF WATER COMMISSIONERS

If well telescopes please sketch and show depths.

GROUND LEVEL

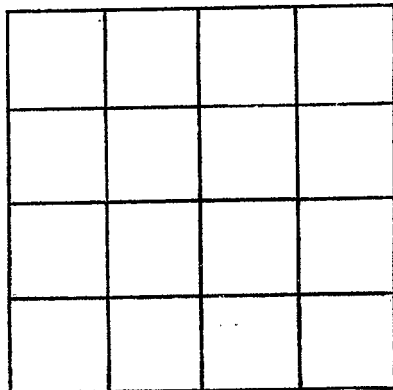

SECTION \_\_\_\_\_

Please indicate well location X.

ADDITIONAL INFORMATION

If more than one screen,  
show locations of each on sketch.