

Union
 G 2002
 6/23/76

MISSISSIPPI
 BOARD OF WATER COMMISSIONERS
 416 North State Street
 Jackson, Mississippi 39201

WATER WELL DRILLERS LOG

6-23 1976 J.W. Walker & Son Union
 date well completed firm name county well located

LANDOWNER: Ozzie & McKelvey
 new alhany

description of formations encountered	from	to
Soil	0	1
Bumbia + sand	1	45
sand + soft Blue Rock	49	100
Hard Blue Rock	100	310
Water Rock	310	315
Water Sand & Rock (off 0.5 sand)	315	460

(mailing address)

WELL LOCATION:
 sec 8 T 70 N R 2 E
 2 miles West of Rockwell
 (distance) (direction) (nearest town)

WELL PURPOSE:
 (home, irrigation, municipal, industrial)


- WELL COMPLETION DATA:
- (1) diameter (inches) 4
 - (2) total depth (feet) 460 ft
 - (3) static water level (feet) 80 ft below top of ground.
 - (4) casing Steel 105 (material) (depth)
 (size) if telescope see back.
 - (5) screen (length) (depth to top)
 (size) (material)
 - (6) pump 1/2 HP (HP) 8 (yield gpm)
 Elec (type power)
 - (7) electric log (yes or no)
 (organization running log)
 - (8) how well bottom plugged

DRILLERS REMARKS:

RECEIVED
 JUL 19 1976
 MISS. BU. OF WATER COMMISSIONERS

If well telescopes please sketch and show depths.

GROUND LEVEL

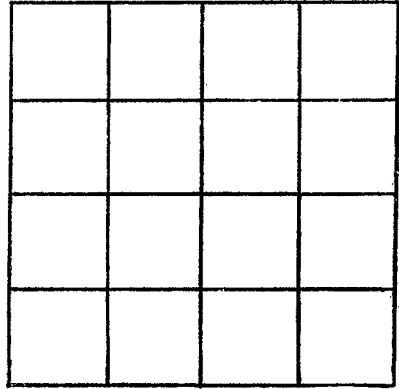

SECTION _____

Please indicate well location X.

ADDITIONAL INFORMATION

If more than one screen,
show locations of each on sketch.