

**MISSISSIPPI
BOARD OF WATER COMMISSIONERS**
416 North State Street
Jackson, Mississippi 39201

Union
G 2003
9-14-76

15F

WATER WELL DRILLERS LOG

Sept 14 19*76* *J. W. Webberson* *Union*
date well completed firm name county well located

LANDOWNER: *Hugh Turner*

description of formations encountered

from to

New Albany
(mailing address)

<i>Soil</i>	<i>0</i>	<i>1</i>
<i>Bumke Clay</i>	<i>1</i>	<i>40</i>
<i>Clay & Sand</i>	<i>40</i>	<i>68</i>
<i>Blue Rock</i>	<i>68</i>	<i>190</i>
<i>Water Rock</i>	<i>190</i>	<i>195</i>
<i>Water Sand & Rocks</i>	<i>195</i>	<i>280</i>
<i>Ripley Sand</i>		

WELL LOCATION:

sec. *16* T. *7* N. R. *2* E.
H miles *West* of *New Albany*
(distance) (direction) (nearest town)

WELL PURPOSE:

(home, irrigation, municipal, industrial)

WELL COMPLETION DATA:

- (1) diameter (inches) *4"*
- (2) total depth (feet) *280'*
- (3) static water level (feet) *12'* below top of ground.
- (4) casing *Steel*, *84'*
(material) (depth)
- _____ if telescope see back.
(size)
- (5) screen *0*, *0*
(length) (depth to top)
- _____ (size) _____ (material)
- (6) pump *1 1/2 HP*, *10*
(HP) (yield gpm)
- Elec*
(type power)
- (7) electric log *no*
(yes or no)
- _____ (organization running log)
- (8) how well bottom plugged _____


RECEIVED
OCT - 1 1976

DRILLERS REMARKS:

MISSISSIPPI BOARD OF WATER COMMISSIONERS

If well telescopes please sketch and show depths.

GROUND LEVEL

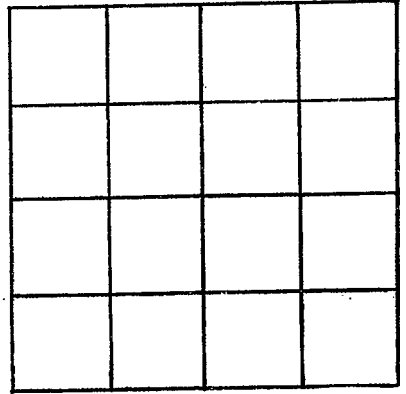

SECTION _____

Please indicate well location X.

ADDITIONAL INFORMATION

If more than one screen, show locations of each on sketch.