

Union
G 2004
9-27-76

MISSISSIPPI
 BOARD OF WATER COMMISSIONERS
 416 North State Street
 Jackson, Mississippi 39201

WATER WELL DRILLERS LOG UNION

9/27/76 date well completed 15F MEDLIN WELL DRILLING firm name ROB county well located

LANDOWNER: ROBERT HALL

description of formations encountered

from to

NEWALBANY MISS

(mailing address)

WELL LOCATION:

sec. 7 T N R 2 E
3 miles SOUTH of Medlin
 (distance) (direction) (nearest town)

WELL PURPOSE: HOME
 (home, irrigation, municipal, industrial)

WELL COMPLETION DATA:

- (1) diameter (inches) 4
- (2) total depth (feet) 160
- (3) static water level (feet) 40 below above top of ground.
- (4) casing Plastic, 70
 (material) (depth)
 (size) If telescope see back.
- (5) screen Ø
 (length) (depth to top)
 (size) (material)
- (6) pump 2.846, 14
 (HP) (yield gpm)
 (type power)
- (7) electric log yes or no
 (organization running log)
- (8) how well bottom plugged Ø

Clay	0	20
Clay Rock	20	50
Blue Mud	50	100
Sand Rock	110	160

Need section

RECEIVED


DEC 2 1976

DRILLERS REMARKS: Ø

MISS. BD. OF WATER COMM.

If well telescopes please sketch and show depths.

GROUND LEVEL

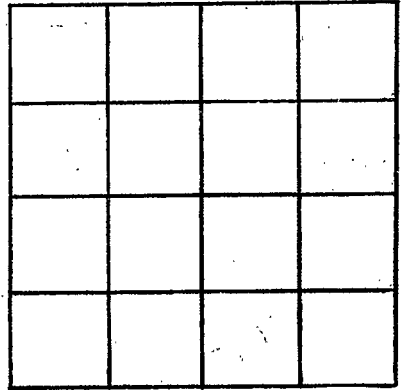

SECTION _____

Please indicate well location X.

ADDITIONAL INFORMATION

If more than one screen, show locations of each on sketch.