

UNION  
G 2005  
6-15-77

MISSISSIPPI  
BOARD OF WATER COMMISSIONERS  
416 North State Street  
15F Jackson, Mississippi 39201

WATER WELL DRILLERS LOG

6-15 date well completed  
1977 Medlin Well Drilling Union firm name  
Union county well located

LANDOWNER: Jerry Dourse  
Mystelle Miss  
(mailing address)

description of formations encountered	from	to
Open	0	50
Blue Clay	50	300
Sand & Gravel	300	380

WELL LOCATION:  
sec. 2 T 6 N 7 R 2 E  
3 miles South of Mystelle  
(distance) (direction) (nearest town)

WELL PURPOSE:  
 home irrigation, municipal, industrial

- WELL COMPLETION DATA:
- (1) diameter (inches) 3 3/4
  - (2) total depth (feet) 380
  - (3) static water level (feet) 110 <sup>(below top of ground)</sup>
  - (4) casing Plastic 140  
(material) (depth)  
(size) If telescope see back.
  - (5) screen (length) (depth to top)  
(size) (material)
  - (6) pump 1/2 Sub 8  
(HP) (yield gpm)  
(type power)
  - (7) electric log (yes or no)
  - (organization running log)
  - (8) how well bottom plugged Open


DRILLERS REMARKS:

RECEIVED  
SEP 29 1977

MISS. BD. OF WATER COMMISSIONERS

If well telescopes please sketch and show depths.

GROUND LEVEL

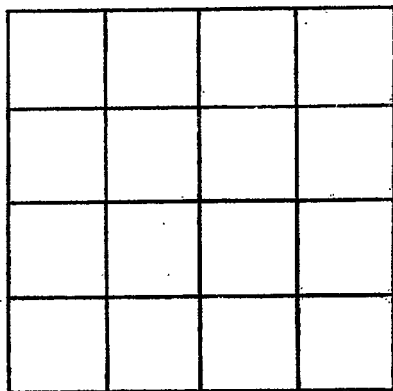

SECTION \_\_\_\_\_

Please indicate well location X.

ADDITIONAL INFORMATION

If more than one screen, show locations of each on sketch.