

UNION
G 2000
6-23-77

MISSISSIPPI
BOARD OF WATER COMMISSIONERS
416 North State Street
Jackson, Mississippi 39201

WATER WELL DRILLERS LOG

6-23-77 19 date well completed
Medlen Well firm name
Union county well located

LANDOWNER:
Mary Stanford
New Albany, Miss.
(mailing address)

description of formations encountered	from	to
Clay		40
Clay & sand	40	80
Blue Clay	80	200
Sand & rock	200	275

WELL LOCATION:
sec. 1 T. 7 N. R. 2 E.
3 1/2 miles West of New Albany
(distance) (direction) (nearest town)

WELL PURPOSE:
(home, irrigation, municipal, industrial)

- WELL COMPLETION DATA:
- (1) diameter (inches) 4
 - (2) total depth (feet) 275
 - (3) static water level (feet) 75 below top of ground
 - (4) casing P.V.C. 100 (material) (depth)
 - (size) If telescope see back.
 - (5) screen (length) (depth to top)
 - (size) (material)
 - (6) pump 1/2 sub 11 (HP) (yield gpm)
 - (type power)
 - (7) electric log (yes or no)
 - (organization running log)
 - (8) how well bottom plugged Open


DRILLERS REMARKS:

RECEIVED
SEP 29 1977

MISS. BD. OF WATER COMM.

If well telescopes please sketch and show depths.

GROUND LEVEL

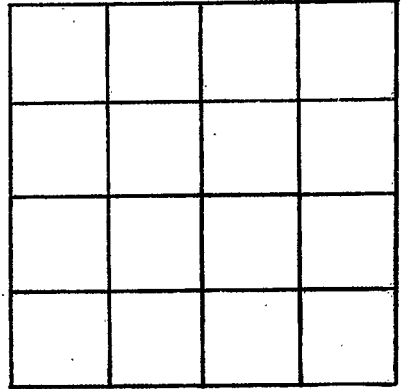

SECTION _____

Please indicate well location X.

ADDITIONAL INFORMATION

If more than one screen,
show locations of each on sketch.