

UNION
 G 2007
 7-8-77

MISSISSIPPI
 BOARD OF WATER COMMISSIONERS
 416 North State Street
 Jackson, Mississippi 39201

WATER WELL DRILLERS LOG

7-8-77 date well completed. 15F Medlin Well Drilling, Union firm name Union county well located

LANDOWNER:
 Captain Thomas
 Myrtle Mrs.
 (mailing address)

description of formations encountered	from	to
Clay	0	30
Mixed Clay	30	100
Blue Clay		
Sand & Rock	100	300
Sand & Rock	300	380

WELL LOCATION:
 sec. 2 T. 4 N. R. 2 E
 3 miles South of Myrtle
 (distance) (direction) (nearest town)

WELL PURPOSE:
 (home) irrigation, municipal, industrial

- WELL COMPLETION DATA:
- (1) diameter (inches) 3 8/4
 - (2) total depth (feet) 380
 - (3) static water level (feet) 90 below top of ground
 - (4) casing Rh (material) 135 (depth)
 - (size) If telescope see back.
 - (5) screen (length) (depth to top)
 - (size) (material)
 - (6) pump 1/2 hp (HP) 10 (yield gpm)
 - (type power)
 - (7) electric log (yes or no)
 - (organization running log)
 - (8) how well bottom plugged OPEN


DRILLERS REMARKS:

RECEIVED
 SEP 30 1977

MISS. BD. OF WATER COMM.

If well telescopes please sketch and show depths.

GROUND LEVEL

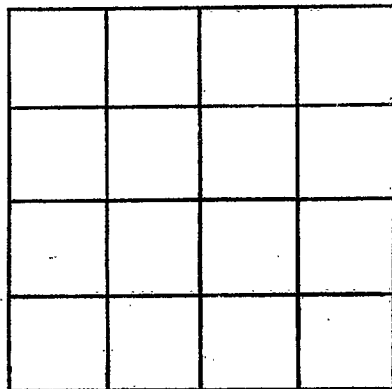

SECTION _____

Please indicate well location X.

ADDITIONAL INFORMATION

If more than one screen, show locations of each on sketch.