

**MISSISSIPPI
BOARD OF WATER COMMISSIONERS**
416 North State Street
Jackson, Mississippi 39201

WATER WELL DRILLERS LOG

UNION
G 2010
7-7-79

7-7-79 19 7-7-79 J. W. Webb & Sons Union
date well completed firm name county well located

LANDOWNER: J. W. Webb & Sons

description of formations encountered	from	to
Soil	0	1
Mudstone	1	37
Blue Shell & Rocks	37	73
Blue Rock	73	177
Water Rock	177	204
Sand & Rocks	204	357

(mailing address)
WELL LOCATION:
sec. 3 T 7 N R. 2 E
S W
4 miles West of unwalking
(distance) (direction) (nearest town)

WELL PURPOSE:
(home, irrigation, municipal, industrial)

- WELL COMPLETION DATA:**
- (1) diameter (inches) 5"
 - (2) total depth (feet) 350
 - (3) static water level (feet) 91 below above top of ground.
 - (4) casing steel 84'
(material) (depth)
 - 0 if telescope see back.
(size)
 - (5) screen 0 0
(length) (depth to top)
 - (size) (material)
 - (6) pump 1/2 HP Sub 3
(HP) (yield gpm)
 - Elec
(type power)
 - (7) electric log _____
(yes or no)
 - (organization running log)
 - (8) how well bottom plugged open

DRILLERS REMARKS:


Miss. Board of Water Comm.

JUL 19 1979

RECEIVED

If well telescopes please sketch and show depths.

GROUND LEVEL

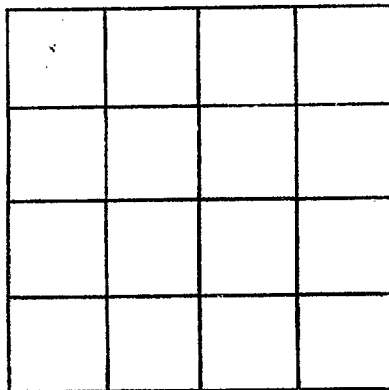

SECTION _____

Please indicate well location X.

ADDITIONAL INFORMATION

If more than one screen, show locations of each on sketch.