

UNION
G 2011
8/18/79

**MISSISSIPPI
BOARD OF WATER COMMISSIONERS**
416 North State Street
Jackson, Mississippi 39201

WATER WELL DRILLERS LOG

8 18 19 79 *J T Meekins* *Union*
 date well completed firm name county well located

LANDOWNER: *Roman Rogers*
New Albany
Marion Town R#
 (mailing address)

description of formations encountered	from	to
<i>Clay</i>	<i>0</i>	<i>10</i>
<i>sand</i>	<i>10</i>	<i>37</i>
<i>rock</i>	<i>37</i>	<i>40</i>
<i>Clay</i>	<i>40</i>	<i>70</i>
<i>rock & sand</i>	<i>70</i>	<i>190</i>

WELL LOCATION:
 sec. *24* T *2* N R *2* E
3 miles *SW* of *New Albany*
 (distance) (direction) (nearest town)

WELL PURPOSE:
 (home, irrigation, municipal, industrial)

WELL COMPLETION DATA:

(1) diameter (inches) *4*

(2) total depth (feet) *190*

(3) static water level (feet) *18* below/above top of ground.

(4) casing *P* *48*
 (material) (depth)

_____ if telescope see back.
 (size)

(5) screen _____
 (length) (depth to top)

_____ (size) _____ (material)

(6) pump *5* *14*
 (HP) (yield gpm)

E
 (type power)

(7) electric log (yes or no) _____

_____ (organization running log)

(8) how well bottom plugged _____

DRILLERS REMARKS:


Miss. Board of Water Comm.

AUG 22 1979

RECEIVED

If well telescopes please sketch and show depths.

GROUND LEVEL

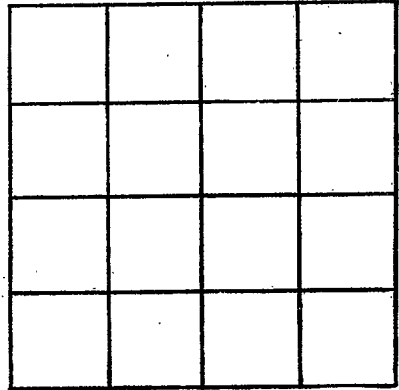

SECTION _____

Please indicate well location X.

ADDITIONAL INFORMATION

If more than one screen, show locations of each on sketch.