

Union
G 203
10-11-80

MISSISSIPPI
BOARD OF WATER COMMISSIONERS
416 North State Street
Jackson, Mississippi 39201

WATER WELL DRILLERS LOG

10-11-80 date well completed 19 80 J.T. Walker firm name Union county well located

LANDOWNER: E.P. McILWAIN
MAYTLE MS
Box 282 38650
(mailing address)

description of formations encountered		from	to
Clay		0	330
rock sand		330	420

WELL LOCATION:
sec 1 T 27 N R 2 E
4 miles S of MYTLE
(distance) (direction) (nearest town)

WELL PURPOSE:
(home, irrigation, municipal, industrial)


- WELL COMPLETION DATA:
- (1) diameter (inches) 4
 - (2) total depth (feet) 420
 - (3) static water level (feet) 50 below top of ground
 - (4) casing PVC 200 (material) (depth)
(size) if telescope see back.
 - (5) screen (length) (depth to top)
(size) (material)
 - (6) pump 10 pump (HP) (yield gpm)
(type power)
 - (7) electric log (yes or no)
(organization running log)
 - (8) how well bottom plugged *OK*

DRILLERS REMARKS:

DEPT. OF NATURAL RESOURCES
BUREAU OF LAND & WATER RESOURCES
OCT 23 1980
RECEIVED

If well telescopes please sketch and show depths.

GROUND LEVEL

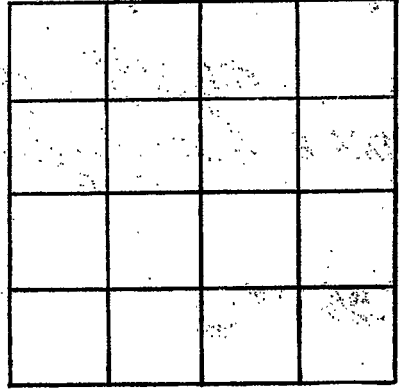

SECTION _____

Please indicate well location X.

ADDITIONAL INFORMATION

If more than one screen,
show locations of each on sketch.