

Union  
G  
205

MISSISSIPPI  
BOARD OF WATER COMMISSIONERS  
416 North State Street  
Jackson, Mississippi 39201

WATER WELL DRILLERS LOG

date well completed 19 7-18-81 firm name J.T. Mullin county well located Union

LANDOWNER: 9-18-81  
A.B. Gregory  
New Albany MS,  
(mailing address)

description of formations encountered	from	to
<u>Rock of sand</u>	<u>0</u>	<u>100</u>
<u>Clay</u>	<u>100</u>	<u>250</u>
<u>Rock - limestone</u>	<u>30</u>	<u>360</u>

WELL LOCATION:  
sec 10 T 7 N R 2 E  
4 miles W of New Albany  
(distance) (direction) (nearest town)

WELL PURPOSE:  
(home, irrigation, municipal, industrial)

WELL COMPLETION DATA:

(1) diameter (inches) 4

(2) total depth (feet) 360

(3) static water level (feet) 10 below top of ground. above

(4) casing PVC 180  
(material) (depth)

(size) If telescope see back.

(5) screen (length) (depth to top)

(size) (material)

(6) pump 1/2 10  
(HP) (yield gpm)

Ele  
(type power)

(7) electric log (yes or no)

(organization running log)

(8) how well bottom plugged

DRILLERS REMARKS:


MISSISSIPPI DEPARTMENT OF NATURAL RESOURCES  
BUREAU OF LAND & WATER RESOURCES

MAR 15 1982

RECEIVED

If well telescopes please sketch and show depths.

GROUND LEVEL

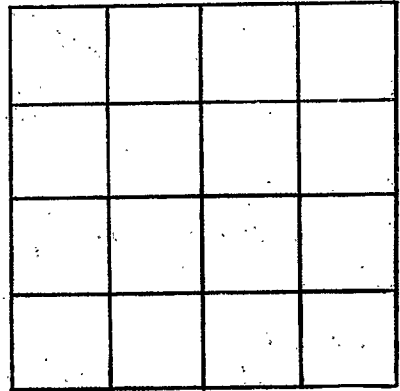

SECTION \_\_\_\_\_

Please indicate well location X.

ADDITIONAL INFORMATION

If more than one screen, show locations of each on sketch.