

Union
G
2016

MISSISSIPPI DEPARTMENT OF NATURAL RESOURCES  
 Bureau of Land and Water Resources  
 Southport Mall  
 P.O. Box 10631  
 Jackson, Mississippi 39209  
**WATER WELL DRILLERS LOG**

9-8 1982 date well completed J.T. Medlin Union firm name Union county well located

LANDOWNER:  
 Gene Stenson  
 Hwy 30 W. New Albany, MS.  
 (mailing address)

WELL LOCATION:  
 sec 2 T 7 N R 2 E  
 3 miles N of New Albany  
 (distance) (direction) (nearest town)

WELL PURPOSE:  
 (home, irrigation, municipal, industrial)

- WELL COMPLETION DATA
- (1) diameter (inches) 4
  - (2) total depth (feet) 340
  - (3) static water level (feet) 60' below top of ground.
  - (4) casing PVC 80 (material) (depth)
  - (size) if telescope see back.
  - (5) screen (length) (depth to top)
  - (size) (material)
  - (6) pump 1/2 (HP) 11 (yield gpm)
  - ele (type power)
  - (7) electric log (yes or no)
  - (organization running log)
  - (8) how well bottom plugged

description of formations encountered	from	to
	Blue Clay	0
Clay Rock	120	340
Rock Band	310	340

DEPT. OF NATURAL RESOURCES  
 BUREAU OF LAND & WATER RESOURCES


NOV 22 1982

**RECEIVED**

DRILLERS REMARKS:

If well telescopes please sketch and show depths.

GROUND LEVEL

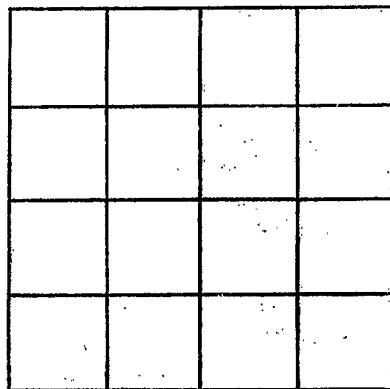

SECTION \_\_\_\_\_

Please indicate well location X.

ADDITIONAL INFORMATION

If more than one screen,  
show locations of each on sketch.