




If well telescopes please sketch and show depths.

GROUND LEVEL

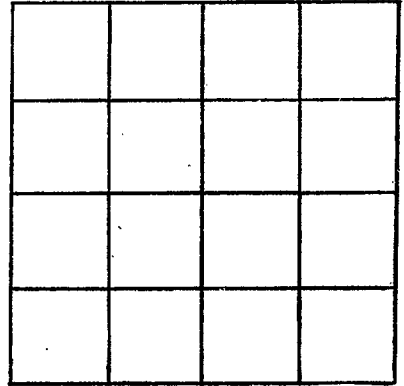

SECTION \_\_\_\_\_

Please indicate well location X.

ADDITIONAL INFORMATION

Lined area for providing additional information, consisting of 20 horizontal lines.

If more than one screen, show locations of each on sketch.