

MISSISSIPPI DEPARTMENT OF NATURAL RESOURCES
Bureau of Land and Water Resources
 Southport Mall
 P.O. Box 10631
 Jackson, Mississippi 39209
WATER WELL DRILLERS LOG

Union
G
2020

8-21-85
 date well completed

19 Medlin Water Well
 firm name

Union
 county well located

LANDOWNER:
Douglas Siddall
Monticello, MS
 (mailing address)

description of formations encountered	from	to
<u>Top soil</u>	<u>0</u>	<u>60</u>
<u>Sand & rock</u>	<u>60</u>	<u>180</u>
<u>Sand & Water</u>	<u>180</u>	<u>210</u>
<u>Aquifer</u>	<u>210</u>	<u>300</u>

WELL LOCATION:
 sec. 2 T. 7 N. R. 20 E.
5 miles South of N.A.
 (distance) (direction) (nearest town)

WELL PURPOSE:
 (home) irrigation, municipal, industrial

WELL COMPLETION DATA:

(1) diameter (inches) 4"

(2) total depth (feet) 300 ft.

(3) static water level (feet) 120' below above top of ground.

(4) casing PVC, 230'
 (material) (depth)

(size) if telescope see back.

(5) screen _____
 (length) (depth to top)

(size) (material)

(6) pump 1/2 10
 (HP) (yield gpm)

Electric
 (type power)

(7) electric log _____
 (yes or no)

(organization running log)

(8) how well bottom plugged _____


RECEIVED
 MAR 8 - 1986

DRILLERS REMARKS:

Department of Natural Resources
 Bureau of Land & Water Resources

If well telescopes please sketch and show depths.

GROUND LEVEL

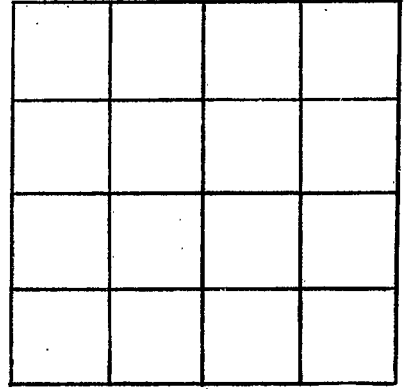

SECTION _____

Please indicate well location X.

ADDITIONAL INFORMATION

A series of horizontal lines for entering additional information, located below the 'ADDITIONAL INFORMATION' header.

If more than one screen, show locations of each on sketch.