

MISSISSIPPI DEPARTMENT OF NATURAL RESOURCES

Bureau of Land and Water Resources

Southport Mall

P.O. Box 10631

Jackson, Mississippi 39209

WATER WELL DRILLERS LOG

Union
G 2221

12.7.85
date well completed

Medlin Water Well
firm name

Union
county well located

LANDOWNER:
Joe Edwards
Mountain Road, N.A.
(mailing address)

description of formations encountered	from	to
Top soil	0	80
Rock	80	110
Clay	110	270
Aquifer	270	320

WELL LOCATION:
sec. 2 T. 7 N. R. 2 E.
5 miles South of Abbeville
(distance) (direction) (nearest town)

WELL PURPOSE:
(home, irrigation, municipal, industrial)

WELL COMPLETION DATA:

(1) diameter (inches) 4"

(2) total depth (feet) 320'

(3) static water level (feet) 90 below top of ground. above

(4) casing PVC 180'
(material) (depth)

_____ If telescope see back.
(size)

(5) screen _____
(length) (depth to top)

_____ (size) _____ (material)

(6) pump 1/2 9
(HP) (yield gpm)


Electric
(type power)

(7) electric log _____
(yes or no)

_____ (organization running log)


(8) how well bottom plugged _____

DRILLERS REMARKS:

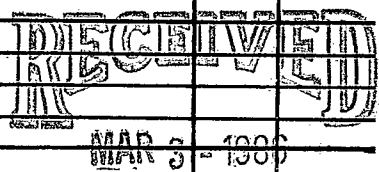

If well telescopes please
sketch and show depths.

GROUND LEVEL

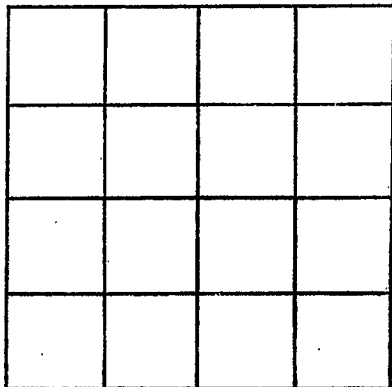

SECTION _____

Please indicate well location X.

ADDITIONAL INFORMATION

If more than one screen,
show locations of each on sketch.