

MISSISSIPPI DEPARTMENT OF NATURAL RESOURCES

Bureau of Land and Water Resources

Southport Mall

P.O. Box 10631

Jackson, Mississippi 39209

WATER WELL DRILLERS LOG

UNION
G
2022

5-1-86

date well completed

Medlin Water Well Union

firm name

county well located

LANDOWNER: Billy Harrison
Beverly Rd.
New Albany, MS
(mailing address)

description of formations encountered	from	to
Top soil	0	90
Clay & Rock	90	190
Clay (Blue)	190	290
Shell & limestone & Aquifer	290	500

WELL LOCATION:
 sec. 2 T. 7 N. R. 2 E.
2 miles W of New Albany
(distance) (direction) (nearest town)

WELL PURPOSE:
 home irrigation, municipal, industrial

WELL COMPLETION DATA:

(1) diameter (inches) 4"

(2) total depth (feet) 500 ft

(3) static water level (feet) 200 (below/above top of ground)

(4) casing PVC, 250"
(material) (depth)
 _____ if telescope see back.
(size)

(5) screen _____
(length) (depth to top)
(size) (material)

(6) pump 1 9
(HP) (yield gpm)
Electric
(type power)

(7) electric log _____
(yes or no)

(organization running log)

(8) how well bottom plugged _____


RECEIVED
 JUN 27 1986

Department of Natural Resources
 Bureau of Land & Water Resources

DRILLERS REMARKS:

If well telescopes please
sketch and show depths.

GROUND LEVEL

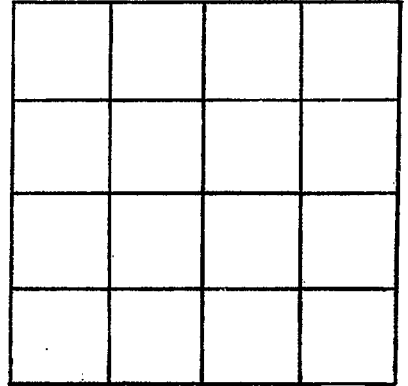

SECTION _____

Please indicate well location X.

ADDITIONAL INFORMATION

If more than one screen,
show locations of each on sketch.