

MISSISSIPPI DEPARTMENT OF NATURAL RESOURCES  
 Bureau of Land and Water Resources  
 Southport Mall  
 P.O. Box 10631

Jackson, Mississippi 39209  
**WATER WELL DRILLERS LOG**

Uron  
G  
2024

MAY 19 87 Tim McMillian Leege Drilling Union  
 date well completed firm name county well located

LANDOWNER: Tim McMillian  
RT 1 Ingomar  
 (mailing address)

WELL LOCATION:  
 sec 27 T 7 N R 2E  
6 miles SW of New Albany  
 (distance) (direction) (nearest town)

WELL PURPOSE: Home  
 (home, irrigation, municipal, industrial)

WELL COMPLETION DATA:  
 (1) diameter (inches) 4"  
 (2) total depth (feet) 207'  
 (3) static water level (feet) 80 below top of ground.  
 (4) casing PVC 197'  
 (material) (depth)  
4" if telescoping see back.  
 (size)  
 (5) screen 10' 197'  
 (length) (depth to top)  
4" PVC  
 (size) (material)  
 (6) pump 1 10  
 (HP) (yield gpm)  
ECCC  
 (type power)  
 (7) electric log no  
 (yes or no)  
 (organization running log)

description of formations encountered	from	to
<u>TOP CLAY</u>	<u>0</u>	<u>20</u>
<u>Blue CLAY</u>	<u>20</u>	<u>60</u>
<u>Limey Rock</u>	<u>160</u>	<u>125</u>
<u>Blue CLAY</u>	<u>120</u>	<u>160</u>
<u>SAND</u>	<u>160</u>	<u>207</u>

**RECEIVED**

MAY 18 1987


Department of Natural Resources  
 Bureau of Land & Water Resources

(8) how well bottom plugged Back wash later

DRILLERS REMARKS:

If well telescopes please sketch and show depths.

GROUND LEVEL

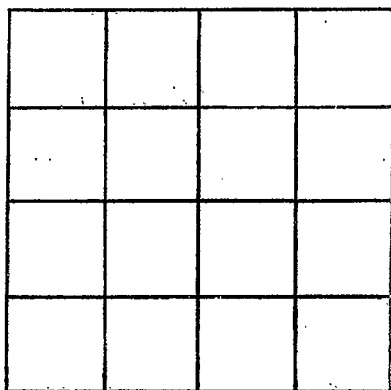

SECTION \_\_\_\_\_

Please indicate well location X.

ADDITIONAL INFORMATION

If more than one screen, show locations of each on sketch.