

MISSISSIPPI DEPARTMENT OF NATURAL RESOURCES


Bureau of Land and Water Resources

Southport Mall

P.O. Box 10631

Jackson, Mississippi 39209

WATER WELL DRILLERS LOG

UNION
 G
 2025

11-19-87
 date well completed

Medlin Well
 firm name

Union
 county well located

LANDOWNER:	description of formations encountered	from	to
Elba Brook Myrtle, MS. (mailing address)			
WELL LOCATION: 10 sec. 2 T. 6 N. R. 2 E. 7 2 miles SW of Myrtle (distance) (direction) (nearest town)			
WELL PURPOSE: (home, irrigation, municipal, industrial)			
WELL COMPLETION DATA:			
(1) diameter (inches) 4"			
(2) total depth (feet) 480'			
(3) static water level (feet) 220' below above top of ground.			
(4) casing PVC, 250' (material) (depth)			
(size) if telescope see back.			
(5) screen (length) (depth to top)			
(size) (material)			
(6) pump 1 (HP), 10 (yield gpm) Electric (type power)			
(7) electric log (yes or no)			
(organization running log)			
(8) how well bottom plugged			

RECEIVED


SEP 28 1989

Department of Natural Resources
 Bureau of Land & Water Resources

DRILLERS REMARKS:

If well telescopes please
sketch and show depths.

GROUND LEVEL

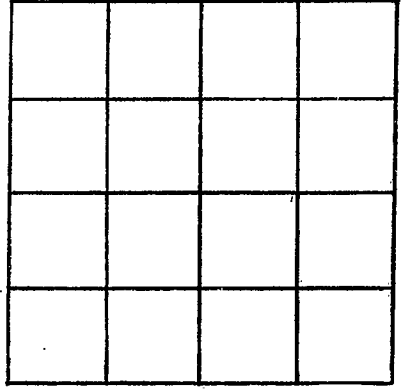

SECTION _____

Please indicate well location X.

ADDITIONAL INFORMATION

If more than one screen,
show locations of each on sketch.