

MISSISSIPPI DEPARTMENT OF NATURAL RESOURCES
Bureau of Land and Water Resources
 Southport Mall
 P.O. Box 10631
 Jackson, Mississippi 39209
WATER WELL DRILLERS LOG

UNION
H

1-18-86

19

Medlin

firm name

Union

county well located

LANDOWNER:

Jony Speck
 New Albany, Miss
 (mailing address)

description of formations encountered

from to

Top soil	0	75
Sand & Rock	75	190
Rock & Shell	190	295
Limestone & Rock	295	360
Aquifer	360	480

WELL LOCATION:

sec. _____ T _____ N _____ R _____ E _____
 S _____ W _____
 _____ miles _____ of _____
 (distance) (direction) (nearest town)

WELL PURPOSE:

(home, irrigation, municipal, industrial)

WELL COMPLETION DATA:

- (1) diameter (inches) 4"
- (2) total depth (feet) 480'
- (3) static water level (feet) 180' below above top of ground.
- (4) casing PVC, 260',
 (material) (depth)
 _____ if telescope see back.
 (size)
- (5) screen _____,
 (length) (depth to top)

 (size) (material)
- (6) pump 3/4, 9
 (HP) (yield gpm)
Electric
 (type power)
- (7) electric log _____
 (yes or no)


 (organization running log)
- (8) how well bottom plugged _____

DRILLERS REMARKS:

RECEIVED
 MAR 3 - 1986

If well telescopes please sketch and show depths.

GROUND LEVEL

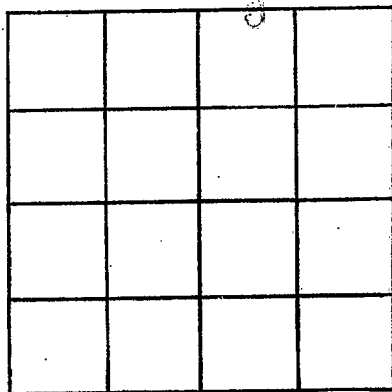

SECTION _____

Please indicate well location X.

ADDITIONAL INFORMATION

If more than one screen,
show locations of each on sketch.