

**CODED**

MISSISSIPPI  
BOARD OF WATER COMMISSIONERS  
416 North State Street  
Jackson, Mississippi 39201

WATER WELL DRILLERS LOG

Union  
H32  
9-28-68  
9-28-68

Lamar Wilber

UNION

date well completed

firm name

county well located

LANDOWNER:

JOE THOMPSON

NEW ALBANY, MISS  
(mailing address)

WELL LOCATION:

sec. 27 T 7<sup>N</sup> R 3<sup>E</sup>  
6 miles E of NEW ALBANY  
(distance) (direction) (nearest town)

WELL PURPOSE:

Home  
(home, irrigation, municipal, industrial)

WELL COMPLETION DATA:


- (1) diameter (inches) 4
- (2) total depth (feet) 260
- (3) static water level (feet) 110 below above top of ground.
- (4) casing STEEL 130 (material) (depth)  
4" (size) if telescope see back.
- (5) screen (length) (depth to top)  
(size) (material)
- (6) pump 3/4 (HP) 5 (yield gpm)  
ELECT- (type power)
- (7) electric log NO (yes or no)  
(organization running log)
- (8) how well bottom plugged

description of formations encountered

from to

|            |     |     |
|------------|-----|-----|
| Red CLAY   | 0   | 60  |
| BLOESHALE  | 60  | 90  |
| LIMESTONE  | 90  | 110 |
| BLUE SHALE | 110 | 180 |
| ROCK SAND  | 180 | 260 |

**CODED**

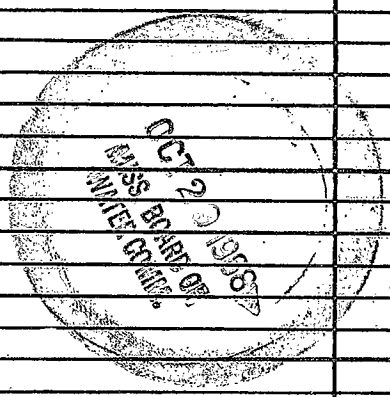

DRILLERS REMARKS:

If well telescopes please sketch and show depths.

GROUND LEVEL

|  |   |  |  |
|--|---|--|--|
|  |   |  |  |
|  | X |  |  |
|  |   |  |  |
|  |   |  |  |

SECTION 27

Please indicate well location X.

ADDITIONAL INFORMATION

If more than one screen, show locations of each on sketch.