

Union
H 39
5-29-70

MISSISSIPPI
BOARD OF WATER COMMISSIONERS
416 North State Street
Jackson, Mississippi 39201

WATER WELL DRILLERS LOG

CODED

5 29 1970

J T Mathis

Union

date well completed

firm name

county well located

LANDOWNER: C W Cellars

R # 1.

New Albany Miss
(mailing address) 216

description of formations encountered

from

to

Clay
Sand
Rock
Lime
Sand
Lime

0 9
9 25
25 106
106 140
112 140
140 170

WELL LOCATION:

sec 33 T 7 N R 3 E
2 miles (distance) S (direction) of New Albany (nearest town)

WELL PURPOSE:

(home, irrigation, municipal, industrial)

WELL COMPLETION DATA:

- (1) diameter (inches) 4
- (2) total depth (feet) 170
- (3) static water level (feet) 57 below above top of ground.
- (4) casing P (material) (depth) (size) if telescope see back.
- (5) screen 40 130 (length) (depth to top) (size) (material)
- (6) pump 1/2 8 (HP) (yield gpm) (type power)
- (7) electric log (yes or no) (organization running log)
- (8) how well bottom plugged

CODED


JUN 3 1970

DRILLERS REMARKS:

MISS. BD. OF
WATER COMM.

If well telescopes please sketch and show depths.

GROUND LEVEL

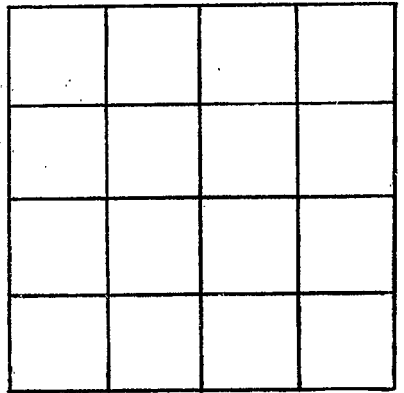

SECTION _____

Please indicate well location X.

ADDITIONAL INFORMATION

If more than one screen, show locations of each on sketch.