

H 47

4-9-62

WATER WELL DRILLERS LOG

CODED

Date: 4-9, 1962 Driller: C F Carlisle County: Winn
 (Name)

(1) Owner of Land: NEW T. WILLIAMS
 (Name)
NEW ALBANY
 (Address)

(2) Location: 1/4 NE 1/4, Sec. 21 T7R3
1/2 miles EAST of NA
 (distance) (direction) (Nearest Town)

(3) Topography: X
 (Hilly) (Flat) (Level)

(4) Purpose of Well: DOMESTIC
 (Domestic Irrigation
 Municipal, Industrial, Other)

Description & Color of Materials Sand, Clay, Red Clay, Shell, etc.	Thick- ness Feet	Depth Feet
RED CLAY	20	20
BLUE DIAT ROCK	20	40
LIMESTONE	25	65
CHALK	235	300
WATER ROCK	298	398
SI SAND	2	400
	25	425

Information upon completion of well:

(1) Diameter 4 inches.

(2) Total Depth 625 feet.

(3) Water Level 30 feet below top of ground.

(4) Cased to 84, Size 4"

(5) Screen: Size _____, Length _____


(6) Were any formations sealed against pollution?
 _____ yes, _____ no.

If YES depth of formation _____

Why _____

Drillers Remarks: _____

CODED

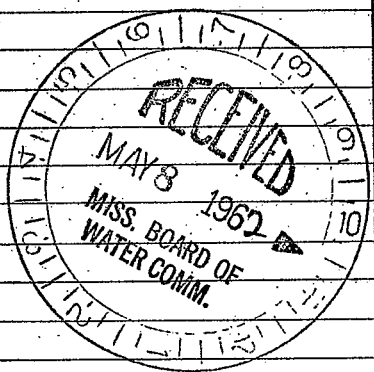

Well No. 251

(Use Back Side)

Faint, illegible text covering the page, possibly bleed-through from the reverse side. The text is too light to transcribe accurately.