

Union
H 49
8-66

WATER WELL DRILLERS LOG

CODED

Date: August 1, 1966, Driller: Cecil Webb County: Union
(Name)

(1) Owner of Land: Dr. New Albany
(Name)
COUNTRY CLUB
(Address)

(2) Location: 1/4, 1/4, Sec 20 T15R3E
3 miles S of N.A.
(distance) (direction) (Nearest Town)

(3) Topography: Hilly
(Hilly) (Flat) (Level)

(4) Purpose of Well:
(Domestic Irrigation
Municipal, Industrial, Other)

Description & Color of Materials Sand, Clay, Red Clay, Shell, etc.	Thick- ness Feet	Depth Feet
Red Clay	0	21
Red Sand, Rocks	21	40
Red Sand	40	50
Blue MARL	50	60
" "	60	80
" "	80	100
WATER SAND	100	120
" (blue) "	120	140
Gray SAND	140	200
Blue MARL	200	220

Information upon completion of well:

(1) Diameter 6" inches.

(2) Total Depth 220' feet.

(3) Water Level _____ feet below top of ground.

(4) Cased to 99, Size 6"

(5) Screen: Size _____, Length _____


(6) Were any formations sealed against pollution?
_____ yes, _____ no.

If YES depth of formation _____

Why _____

Drillers Remarks: _____

CODED

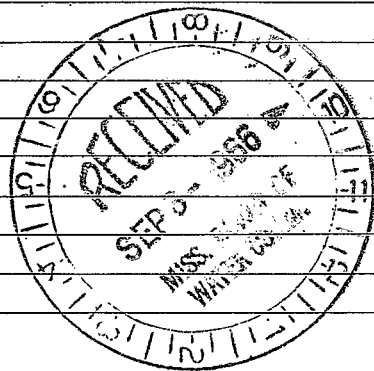

(Use Back Side)

Well No.

