

**Union**  
 H 50 9 19/12  
 1-12-72

MISSISSIPPI  
 BOARD OF WATER COMMISSIONERS  
 416 North State Street  
 Jackson, Mississippi 39201

225.00  
 25  
 25

**COPIED**

**WATER WELL DRILLERS LOG**

1 12 19 72 *J T Melvin* *Union*  
 date well completed firm name county well located

LANDOWNER: *Carl Stephen*  
*New Albany*  
 (mailing address)

description of formations encountered	from	to
<i>W. Clay</i>	<i>0</i>	<i>8</i>
<i>Back 4</i>	<i>8</i>	<i>42</i>
<i>Back 4 sand</i>	<i>42</i>	<i>200</i>

WELL LOCATION:  
 sec. *2* T. *2* N. R. *3*  
 1 miles *SW* of *New Albany*  
 (distance) (direction) (nearest town)

WELL PURPOSE:  
 (home, irrigation, municipal, industrial)


- WELL COMPLETION DATA:
- (1) diameter (inches) *4*
  - (2) total depth (feet) *200*
  - (3) static water level (feet) *6* below/above top of ground.
  - (4) casing *P 60*  
 (material) (depth)  
 (size) if telescope see back.
  - (5) screen \_\_\_\_\_  
 (length) (depth to top)  
 (size) (material)
  - (6) pump *Hand*  
 (HP) (yield gpm)  
 (type power)
  - (7) electric log (yes or no) \_\_\_\_\_  
 (organization running log) \_\_\_\_\_
  - (8) how well bottom plugged \_\_\_\_\_

**COPIED**

DRILLERS REMARKS:

If well telescopes please sketch and show depths.

GROUND LEVEL

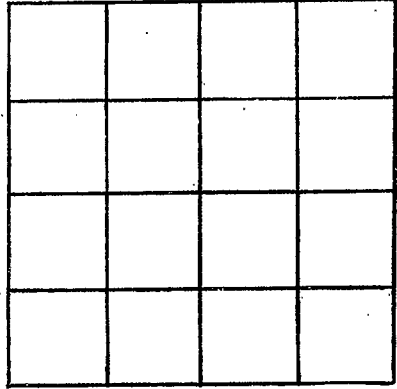

SECTION \_\_\_\_\_

Please indicate well location X.

ADDITIONAL INFORMATION

If more than one screen,  
show locations of each on sketch.