

UNION  
 1751  
 4-18-72

MISSISSIPPI  
 BOARD OF WATER COMMISSIONERS  
 416 North State Street  
 Jackson, Mississippi 39201

600.00  
 CODED  
 00  
 00  
 00

WATER WELL DRILLERS LOG

4 18 1972 J T Medlin UNION  
 date well completed firm name county well located

LANDOWNER:	description of formations encountered	from	to
Ray Mayo	Clay	0	18
New Albany	sand	18	25
Ingomar (mailing address)	rock & clay	25	20
	blue	20	
<b>WELL LOCATION:</b> sec. 30 T 7 N R 3 E S                  W 2 miles N of Ingomar (distance) (direction) (nearest town)			
<b>WELL PURPOSE:</b> (home, irrigation, municipal, industrial)			
<b>WELL COMPLETION DATA:</b>			
(1) diameter (inches)	4		
(2) total depth (feet)	210		
(3) static water level (feet)	30 below top of ground.		
(4) casing (material)	P 80		
(size)	if telescope see back.		
(5) screen (length)	(depth to top)		
(size)	(material)		
(6) pump (HP)	5 6		
(type power)	E (yield gpm)		
(7) electric log (yes or no)			
(organization running log)			
(8) how well bottom plugged			
<b>DRILLERS REMARKS:</b>			


CODED

NOV 9 - 1972

MISS. Bd. of WATER COMMISSIONERS

If well telescopes please  
sketch and show depths.

GROUND LEVEL

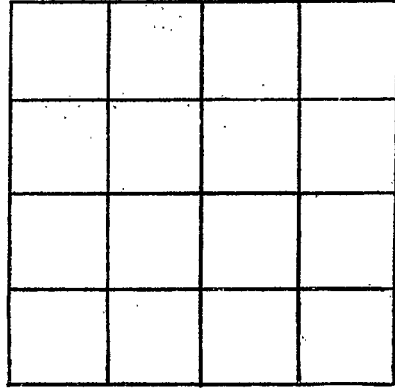

SECTION \_\_\_\_\_

Please indicate well location X.

ADDITIONAL INFORMATION

If more than one screen,  
show locations of each on sketch.