

**UNION**  
**H55**  
**6-8-72**

MISSISSIPPI  
 BOARD OF WATER COMMISSIONERS  
 416 North State Street  
 Jackson, Mississippi 39201

525.00  
 26.25  
 551.25

**WATER WELL DRILLERS LOG**

6-8 1972 J T Meekin UNION  
 date well completed firm name county well located

LANDOWNER: Vice Lamm  
New Albany  
HW 30 E.  
 (mailing address)

| description of formations encountered | from | to  |
|---------------------------------------|------|-----|
| clay                                  | 0    | 16  |
| rock & sand                           | 16   | 47  |
| blue clay & rock                      | 47   | 118 |
| blue " "                              | 118  | 187 |
| rock & sand                           | 187  | 320 |

WELL LOCATION:  
 sec. 2 T 7 N R 3 E  
5 miles E of New Albany  
 (distance) (direction) (nearest town)

WELL PURPOSE:  
 (home, irrigation, municipal, industrial)

WELL COMPLETION DATA:

(1) diameter (inches) 4

(2) total depth (feet) 320

(3) static water level (feet) 80 below above top of ground.

(4) casing P 140  
 (material) (depth)  
 (size) if telescope see back.

(5) screen \_\_\_\_\_  
 (length) (depth to top)  
 (size) (material)

(6) pump \_\_\_\_\_  
 (HP) (yield gpm)  
E  
 (type power)

(7) electric log \_\_\_\_\_  
 (yes or no)  
 (organization running log)

(8) how well bottom plugged open


DRILLERS REMARKS:

JUL 19 1972

MISS. Bd. Of  
 WATER COMMISSIONERS

If well telescopes please  
sketch and show depths.

GROUND LEVEL

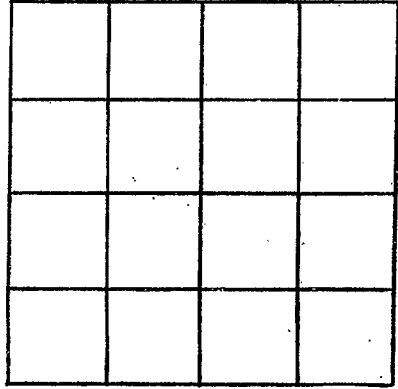

SECTION \_\_\_\_\_

Please indicate well location X.

ADDITIONAL INFORMATION

If more than one screen,  
show locations of each on sketch.