

Union
H56
10-12-72

FHA
MISSISSIPPI
BOARD OF WATER COMMISSIONERS
416 North State Street
Jackson, Mississippi 39201

#650.00
3250
Total 68250

WATER WELL DRILLERS LOG

CODED

10 12 1972
date well completed

J. J. Medina
firm name

Union
county well located

LANDOWNER: Virginal Mathis

New Albany
Miss
(mailing address)

description of formations encountered

from

to

Clay	0	17
sand or rock	17	46
blue clay	146	160
rock & sand	160	270

WELL LOCATION:

sec. 7 T. 7 N. R. 3 E.
2 miles N of INGOMMA
(distance) (direction) (nearest town)

WELL PURPOSE:

(home, irrigation, municipal, industrial)

WELL COMPLETION DATA:

- (1) diameter (inches) 4
- (2) total depth (feet) 270
- (3) static water level (feet) 16 below/above top of ground.
- (4) casing P 50
(material) (depth)
_____ if telescope see back.
(size)
- (5) screen _____
(length) (depth to top)
5 _____
(size) (material)
- (6) pump 5 6
(HP) (yield gpm)
E
(type power)
- (7) electric log _____
(yes or no)

(organization running log)
- (8) how well bottom plugged _____


CODED

DRILLERS REMARKS:

APR 11 1972

If well telescopes please sketch and show depths.

GROUND LEVEL

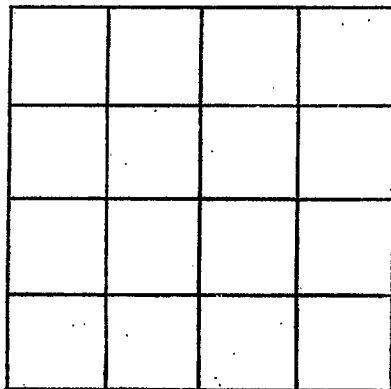

SECTION _____

Please indicate well location X.

ADDITIONAL INFORMATION

A series of horizontal lines for recording additional information.

If more than one screen, show locations of each on sketch.