

Union  
H 58  
4-13-73

MISSISSIPPI  
BOARD OF WATER COMMISSIONERS  
416 North State Street  
Jackson, Mississippi 39201

CODED 10.00  
30.50  
Total 640.58

WATER WELL DRILLERS LOG

4 13 19 23  
date well completed

J T Medlin  
firm name

Union  
county well located

LANDOWNER: James E Gibson  
New Albany Miss  
(mailing address)

description of formations encountered	from	to
	Clay	0
sand	8	28
Rock & Sand	28	100

WELL LOCATION:

sec. 18 T 7 N R 3 E  
5 miles S of New Albany  
(distance) (direction) (nearest town)

WELL PURPOSE:

(home, irrigation, municipal, industrial)

WELL COMPLETION DATA:

- (1) diameter (inches) 4
- (2) total depth (feet) 110
- (3) static water level (feet) 10 below top of ground.
- (4) casing P 100 (material) (depth)  
(size) if telescope see back.
- (5) screen 10 100 (length) (depth to top)  
4 P (size) (material)
- (6) pump 5 6 (HP) (yield gpm)  
E (type power)
- (7) electric log (yes or no)
- (organization running log)
- (8) how well bottom plugged Cap


CODED

MAY 11 1973

DRILLERS REMARKS:

If well telescopes please sketch and show depths.

GROUND LEVEL

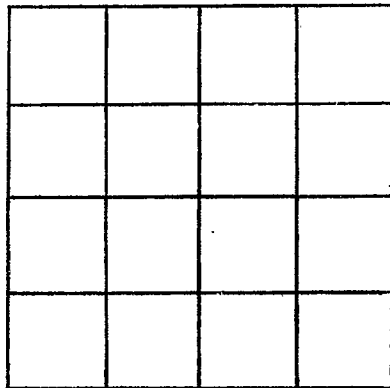

SECTION \_\_\_\_\_

Please indicate well location X.

ADDITIONAL INFORMATION

If more than one screen, show locations of each on sketch.