

UNION
H 61
8-28-73

MISSISSIPPI
BOARD OF WATER COMMISSIONERS CODED
416 North State Street
Jackson, Mississippi 39201

Union Co.

WATER WELL DRILLERS LOG

8-28 1968 Union Well Drilling Union
date well completed firm name county well located

LANDOWNER: Leo Turner
RT 3 New Albany
(mailing address)

description of formations encountered	from	to
red sand	0	57
mix. S + Clay	57	57
blue	57	220
granite	220	13.5
grind	439	611

WELL LOCATION:
sec 27 T 7 N R 3 E
5 miles (distance) S W of Shumard (nearest town)

WELL PURPOSE:
(home, irrigation, municipal, industrial)

CODED

WELL COMPLETION DATA:
(1) diameter (inches) 4
(2) total depth (feet) 611
(3) static water level (feet) 105 below above top of ground.
(4) casing 2 0 4 (material) (depth) if telescope see back. (size)
(5) screen 0 (length) (depth to top) (size) (material)
(6) pump 1 (HP) 1250 (yield gpm) EP 200 (type power)
(7) electric log (yes or no) (organization running log)
(8) how well bottom plugged


DEC 10 1968

MISS. BD. OF WATER COMM.

DRILLERS REMARKS:

If well telescopes please sketch and show depths.

GROUND LEVEL

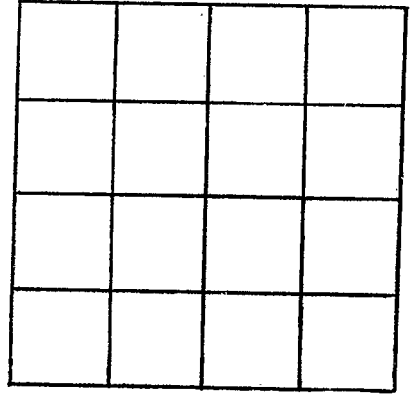

SECTION _____

Please indicate well location X.

ADDITIONAL INFORMATION

If more than one screen,
show locations of each on sketch.