

UNION
H 200
7-18-77

MISSISSIPPI
BOARD OF WATER COMMISSIONERS
416 North State Street
Jackson, Mississippi 39201

WATER WELL DRILLERS LOG

7-18-77 19 *Medlin Well Drilling, Union*
date well completed firm name county well located

LANDOWNER:
Brownie Johnson
New Orleans
(mailing address)

description of formations encountered	depth	
	from	to
<i>Clay</i>	<i>0</i>	<i>50</i>
<i>Blue clay</i>	<i>50</i>	<i>140</i>
<i>Sand & Gravel</i>	<i>140</i>	<i>200</i>

WELL LOCATION:
sec. 3 T. 67 N. R. 3 E.
3 1/2 miles East of Meridian
(distance) (direction) (nearest town)

WELL PURPOSE:
(home, irrigation, municipal, industrial)

- WELL COMPLETION DATA:
- (1) diameter (inches) 4
 - (2) total depth (feet) 200
 - (3) static water level (feet) 60 below top of ground.
 - (4) casing Plas 85
(material) (depth)
(size) If telescope see back.
 - (5) screen (length) (depth to top)
(size) (material)
 - (6) pump 1/2 Sub 13
(HP) (yield gpm)
(type power)
 - (7) electric log (yes or no)
(organization running log)
 - (8) how well bottom plugged OPEN


DRILLERS REMARKS:

RECEIVED

SEP-30 1977

If well telescopes please sketch and show depths.

GROUND LEVEL

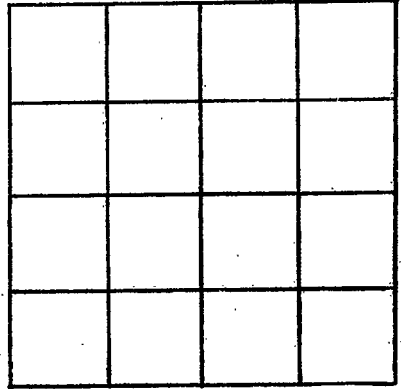

SECTION _____

Please indicate well location X.

ADDITIONAL INFORMATION

If more than one screen, show locations of each on sketch.