

MISSISSIPPI DEPARTMENT OF NATURAL RESOURCES

Bureau of Land and Water Resources

Southport Mall

P.O. Box 10631

Jackson, Mississippi 39209

WATER WELL DRILLERS LOG

UNION  
H 2000  
9-20-81

9-20- 1981 LEEPER Drilling UNION  
 date well completed firm name county well located

LANDOWNER:  
City of New Albany  
New Albany, MS -  
 (mailing address)

WELL LOCATION:  
 sec. 16 T. 7 N. R. 3 E.  
In New Albany  
 (distance) miles (direction) of (nearest town)

WELL PURPOSE: GROUND BED  
 (home, irrigation, municipal, industrial)

WELL COMPLETION DATA:

(1) diameter (inches) 6

(2) total depth (feet) 250

(3) static water level (feet) 40 below above top of ground.

(4) casing Steel, 250  
 (material) (depth)

\_\_\_\_\_ if telescope see back.  
 (size)

(5) screen None  
 (length) (depth to top)

\_\_\_\_\_ (size) \_\_\_\_\_ (material)

(6) pump None  
 (HP) (yield gpm)

\_\_\_\_\_ (type power)

(7) electric log \_\_\_\_\_  
 (yes or no)

\_\_\_\_\_ (organization running log)

(8) how well bottom plugged \_\_\_\_\_

description of formations encountered	from	to
<u>TOP clay</u>	<u>0</u>	<u>10</u>
<u>Red Sand</u>	<u>10</u>	<u>40</u>
<u>Blue Clay</u>	<u>40</u>	<u>80</u>
<u>Shell &amp; coarse Sand</u>	<u>80</u>	<u>140</u>
<u>Blue clay</u>	<u>140</u>	<u>250</u>
<u>Ground Bed</u>		
<u>for City of</u>		
<u>New Albany</u>		
<u>Gas Dept</u>		

DRILLERS REMARKS:


DEPT. OF NATURAL RESOURCES  
 BUREAU OF LAND & WATER RESOURCES

OCT 15 1981

RECEIVED

If well telescopes please sketch and show depths.

GROUND LEVEL

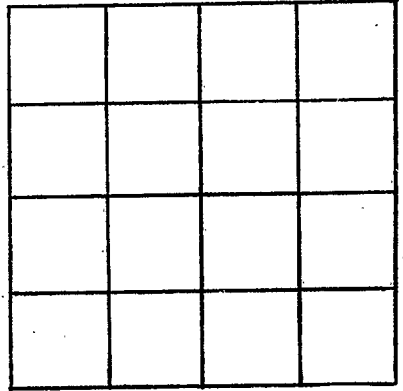

SECTION \_\_\_\_\_

Please indicate well location X.

ADDITIONAL INFORMATION

If more than one screen,  
show locations of each on sketch.