

MISSISSIPPI DEPARTMENT OF NATURAL RESOURCES
Bureau of Land and Water Resources
 Southport Mall
 P.O. Box 10631
 Jackson, Mississippi 39209
WATER WELL DRILLERS LOG

Union
A 2004

5.7.85 19
 date well completed

Medlin
 firm name

Union
 county well located

LANDOWNER:
Raymond May
New Albany, MS.
 (mailing address)

description of formations encountered	from	to
<u>Top - Oil</u>	<u>0</u>	<u>75</u>
<u>Limestone - sand</u>	<u>75</u>	<u>190</u>
<u>Limestone</u>	<u>190</u>	<u>305</u>
<u>Clay & sand</u>	<u>305</u>	<u>410</u>
<u>Aquifer</u>	<u>410</u>	<u>500</u>

WELL LOCATION:
 sec. 3 T. 7 N. R. 3 E.
5 miles S/E of New Albany
 (distance) (direction) (nearest town)

WELL PURPOSE:
 (home irrigation, municipal, industrial)

WELL COMPLETION DATA:

(1) diameter (inches) 4"

(2) total depth (feet) 520'

(3) static water level (feet) 180' below top of ground.

(4) casing PVC, 230',
 (material) (depth)
 _____ if telescope see back.
 (size)

(5) screen _____,
 (length) (depth to top)
 _____,
 (size) (material)

(6) pump 3/4, 7
 (HP) (yield gpm)
Electric
 (type power)

(7) electric log _____
 (yes or no)

 (organization running log)

(8) how well bottom plugged _____


RECEIVED
 MAR 3 - 1986

DRILLERS REMARKS:

Department of Natural Resources
 Bureau of Land & Water Resources

If well telescopes please sketch and show depths.

GROUND LEVEL

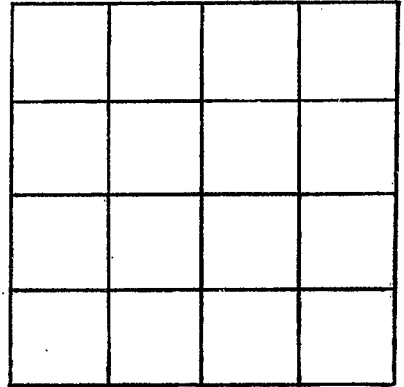

SECTION _____

Please indicate well location X.

ADDITIONAL INFORMATION

If more than one screen,
show locations of each on sketch.