

MISSISSIPPI DEPARTMENT OF ENVIRONMENTAL QUALITY

Office of Land and Water Resources

P. O. Box 10631

Jackson, MS 39289-0631

WATER WELL DRILLERS LOG

COUNTY WELL LOCATED Union	
WELL NUMBER H 2011	CODED
DATE WELL COMPLETED 2-28-99	

PERMIT NUMBER
NAME OF DRILLING FIRM PARKS + PARKS WELL SERVICE

NAME & MAILING ADDRESS OF LANDOWNER J. P. Kirkcum		
7006 CR 279		
NEW ALBANY MS 38652		
WELL LOCATION:	SEC	TOWNSHIP RANGE
	10	7 N 3 E W
DISTANCE	DIRECTION	NEAREST TOWN
2 Miles	S.E.	NEW ALBANY
OTHER LANDMARK		
WELL PURPOSE: <input checked="" type="checkbox"/> Home Irrigation, <input type="checkbox"/> Municipal, <input type="checkbox"/> Industrial, <input type="checkbox"/> Fish Pond, etc.		

PUMP DATA		
PUMP TYPE (Circle One): Submersible, Turbine, Jet, Flowing Well, Other (Describe) HAND		
POWER TYPE (Circle One): Electric, Tractor, Diesel, Gasoline, Butane, Other (Describe) _____ H/P _____		
Pump Capacity (GPM)	No. of Stages	Setting Depth _____ FT.
PUMP TEST		
Well yielded _____ GPM with a drawdown of _____ ft. after _____ hours of pumping		

WELL DATA		
Well Depth 130	Casing Diameter (In.) 4	Casing Length (Ft.) 100
Type of Casing PVC	Hole Depth 130	Depth to Static Water Level
TYPE OF COMPLETION: (Circle One or More): Gravel Packed, Underreamed, Telescoped, Natural Development, Open Hole, Other (Describe) _____		

LOG DATA	
TYPE OF LOG RUN (Circle One): Electric, Gamma Ray, Density, Sonic, Neutron, Other (Describe) No Log Run	
Name of Organization Running Log	

WELL GROUTED TO A DEPTH OF 10 FEET
Type Grout (circle one) Cement , Bentonite, or Mix

GEOLOGIC DATA (Office Use Only)			
Surface Elev.	Geologic Unit	Unit Thickness	Depth to Top
Subs. SWL	Date	Analysis	Aquifer Test

SCREEN DATA		
Diameter - Inches 4	Length - Feet 30	Slot Size - Inches 1010
Screen Type PVC	Depth to Bottom - Feet 130	


Driller's Remarks
Top of Lap Pipe or Reduction in Casing FEET IF TELESCOPED OR MORE THAN ONE SCREEN: USE BACK PAGE

DESCRIPTION OF FORMATIONS ENCOUNTERED	FROM	TO
RED SAND	0	20
CLAY	20	80
SAND	80	130

FORMATIONS (Continued)	FROM	TO
RECEIVED		
JUN 18 2001		
Dept. of Environmental Quality Office of Land & Water Resources		
IF MORE SPACE IS NEEDED, USE BACK		

If well telescopes please sketch and show depths.

GROUND LEVEL

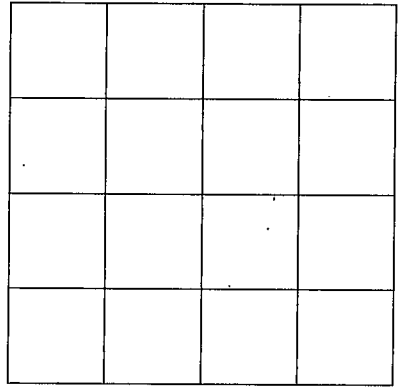

SECTION _____

Please indicate well location X.

ADDITIONAL INFORMATION

If more than one screen;
show location of each on sketch.