

CODED

MISSISSIPPI
BOARD OF WATER COMMISSIONERS
416 North State Street
Jackson, Mississippi 39201

WATER WELL DRILLERS LOG

Union
9 15
10-3-69

Oct 3 1969 J. W. Websters Union
date well completed firm name county well located

LANDOWNER: Ruel Parker

description of formations encountered	from	to
Soil	0	12
pipe clay	12	37
Blue Rock	37	298
Water Sand	298	400
Coal		

Blue Springs
(mailing address)

WELL LOCATION:
sec. 19 T. 13 N. R. 5 E
2 miles northwest of Ellington
(distance) (direction) (nearest town)

WELL PURPOSE:
(home, irrigation, municipal, industrial)

WELL COMPLETION DATA:

- (1) diameter (inches) 5
- (2) total depth (feet) 400
- (3) static water level (feet) 159 below top of ground.
- (4) casing Steel 4 1/2" (material), (depth), 5" (size) if telescope see back.
- (5) screen (length), (depth to top), (size), (material)
- (6) pump 1/2 HP Sub 6 (HP), (yield gpm), Elec. (type power)
- (7) electric log (yes or no), (organization running log)
- (8) how well bottom plugged

CODED


DEC - 8 1969

MISS. BD. OF
WATER COMM.

DRILLERS REMARKS:

If well telescopes please sketch and show depths.

GROUND LEVEL

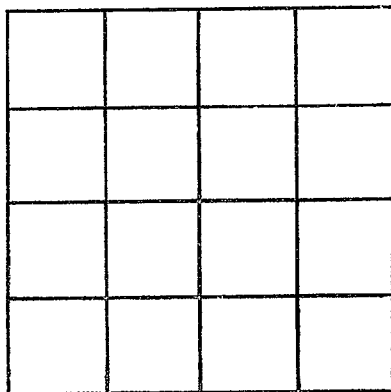

SECTION _____

Please indicate well location X.

ADDITIONAL INFORMATION

If more than one screen, show locations of each on sketch.