

MISSISSIPPI
BOARD OF WATER COMMISSIONERS
416 North State Street
Jackson, Mississippi 39201

CODED

UNION
J17
1-1-70

WATER WELL DRILLERS LOG

1-1 date well completed 1970 J. W. Webb & Sons firm name Union county well located

LANDOWNER: E.F. Harrison

description of formations encountered

from to

Blue springs miss
(mailing address)

Soil	0	9
Bumbo	9	32
Blue Rock	32	415
Water sand	415	526
Coffee		

WELL LOCATION:

sec 11 T 75 N R 4 E
S W
3 miles N.W. of Ellistown
(distance) (direction) (nearest town)

WELL PURPOSE:
(home, irrigation, municipal, industrial)

WELL COMPLETION DATA:

- diameter (inches) 3
- total depth (feet) 526
- static water level (feet) 144 below top of ground.
- casing Steel 39 (material) (depth)
5 (size) if telescope see back.
- screen 0 (length) (depth to top)
(size) (material)
- pump 1/2 HP 8 (HP) (yield gpm)
Elec (type power)
- electric log (yes or no)
(organization running log)
- how well bottom plugged

CODED


J.W.
2 - 1970

MISS. BD. OF
WATER COMM.

DRILLERS REMARKS:

If well telescopes please sketch and show depths.

GROUND LEVEL

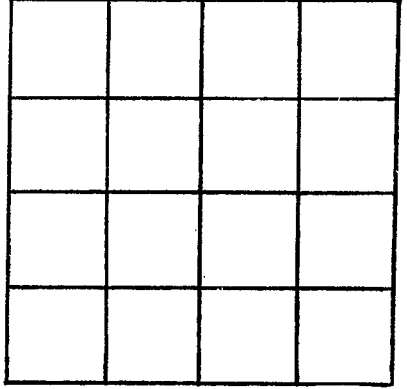

SECTION _____

Please indicate well location X.

ADDITIONAL INFORMATION

If more than one screen, show locations of each on sketch.