

Union
J 21
5-1-70

MISSISSIPPI
BOARD OF WATER COMMISSIONERS,
416 North State Street
Jackson, Mississippi 39201

CODED

WATER WELL DRILLERS LOG

May 1 1970 J. W. Webb & Sons Union
date well completed firm name county well located

LANDOWNER: Leo Kennedy

description of formations encountered

from to

New Albany
(mailing address)

WELL LOCATION: 027

sec. 5 T. 7 N R. 5 E
4 miles north of Center
(distance) (direction) (nearest town)

Soil	0	7
Sand	7	30
Blue Rock	30	213
Water sand	213	269
Blue Rock	269	594
Water Rock	594	595
Water sand	595	715
Coppee		

WELL PURPOSE:
(home, irrigation, municipal, industrial)

WELL COMPLETION DATA:

- (1) diameter (inches) 4"
- (2) total depth (feet) 715
- (3) static water level (feet) 260 below top of ground.
- (4) casing steel, 297 ft (material) (depth)
4 (size) If telescope see back.
- (5) screen 0 (length) 0 (depth to top)
0 (size) 0 (material)
- (6) pump 1 1/2 HP (HP) 3 (yield gpm)
Elec (type power)
- (7) electric log no (yes or no)
no (organization running log)
- (8) how well bottom plugged Open

CODED

JUN 8 1970


MISS. B'D. OF

DRILLERS REMARKS:

If well telescopes please sketch and show depths.

GROUND LEVEL

4"
Casin
297

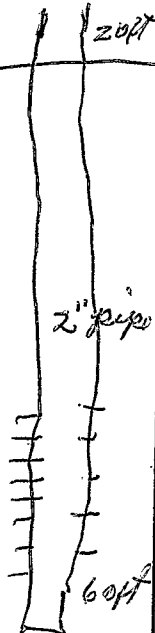

		X	
/			

SECTION 5

Please indicate well location X.

ADDITIONAL INFORMATION

297 ft 4" Casin
set 2" pipe from
bottom up to 20 ft in
Casin

If more than one screen,
show locations of each on sketch.