

MISSISSIPPI  
 BOARD OF WATER COMMISSIONERS  
 416 North State Street  
 Jackson, Mississippi 39201

**CODED**

**WATER WELL DRILLERS LOG**

UNION  
J 23  
10-26-70

Oct 26 1970 J. W. Webb & Sons Union  
 date well completed firm name county well located

LANDOWNER: Bobby Jones

description of formations encountered	from	to
<u>Soil</u>	<u>0</u>	<u>14</u>
<u>Sand &amp; Clay</u>	<u>14</u>	<u>20</u>
<u>Blue Rock</u>	<u>20</u>	<u>214</u>
<u>Water Rock</u>	<u>214</u>	<u>216</u>
<u>Water Sand</u>	<u>216</u>	<u>350</u>

Blue Springs  
 (mailing address)

WELL LOCATION:  
 sec. 31 T 45 N R 5 E  
2 miles East of Fairfield  
 (distance) (direction) (nearest town)

WELL PURPOSE:  
 (home, irrigation, municipal, industrial)

- WELL COMPLETION DATA:
- (1) diameter (inches) 5
  - (2) total depth (feet) 350 ft
  - (3) static water level (feet) 91 below above top of ground.
  - (4) casing Steel 22 ft  
 (material) (depth)  
5 if telescope see back.  
 (size)
  - (5) screen 0 0  
 (length) (depth to top)  
0 0  
 (size) (material)
  - (6) pump 1 1/2 hp 6  
 (HP) (yield gpm)  
Elec  
 (type power)
  - (7) electric log 0  
 (yes or no)  
0  
 (organization running log)
  - (8) how well bottom plugged Open


**CODED**

DRILLERS REMARKS:

NOV 16 1970

If well telescopes please sketch and show depths.

GROUND LEVEL

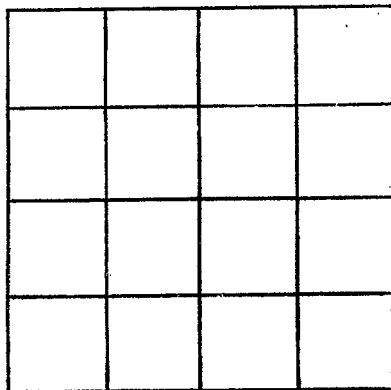

SECTION \_\_\_\_\_

Please indicate well location X.

ADDITIONAL INFORMATION

If more than one screen,  
show locations of each on sketch.