

UNION
 J29
 12-14-70

MISSISSIPPI
 BOARD OF WATER COMMISSIONERS
 416 North State Street
 Jackson, Mississippi 39201

CODED

WATER WELL DRILLERS LOG

Dec 14 1970 J. W. Webber Sons Union
 date well completed firm name county well located

LANDOWNER: <u>Kenneth Haddard</u>	description of formations encountered	from	to
<u>Blue Springs Rt 1</u> (mailing address)	<u>Soil</u>	0	5
WELL LOCATION: sec. <u>23 T 75 N R 4 E</u> <u>S W</u>	<u>Humo & Clay</u>	5	20
(distance) _____ miles _____ of _____ (direction) (nearest town)	<u>Blue Rock</u>	20	297
WELL PURPOSE: (home, irrigation, municipal, industrial)	<u>Water Rock</u>	297	300
WELL COMPLETION DATA:	<u>Water Sand</u>	300	430
(1) diameter (inches) <u>5</u>	<u>Coffee sand</u>		
(2) total depth (feet) <u>430</u>			
(3) static water level (feet) <u>179</u> below above top of ground.			
(4) casing <u>Steel</u> , <u>22ft</u> (material) (depth)			
<u>5"</u> (size) if telescope see back.			
(5) screen <u>0</u> , <u>0</u> (length) (depth to top)			
<u>0</u> , <u>0</u> (size) (material)			
(6) pump <u>3/4 HP sub</u> , <u>8</u> (HP) (yield gpm)			
<u>Elec</u> (type power)			
(7) electric log <u>0</u> (yes or no)			
<u>0</u> (organization running log)			
(8) how well bottom plugged <u>open</u>			
DRILLERS REMARKS:			


CODED

JAN 22 1971

REC'D. BD. OF
 WATER COMMISSIONERS

If well telescopes please sketch and show depths.

GROUND LEVEL

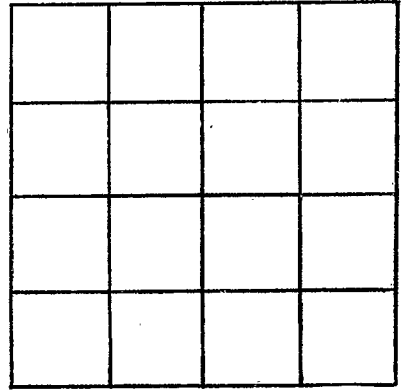

SECTION _____

Please indicate well location X.

ADDITIONAL INFORMATION

If more than one screen,
show locations of each on sketch.