

Union
J28
10-8-71

MISSISSIPPI
BOARD OF WATER COMMISSIONERS
416 North State Street
Jackson, Mississippi 39201

CODED

WATER WELL DRILLERS LOG

Herndon-Homan Well & Supply, Inc.

P. O. Box 42

Union

10-8 1971
date well completed

SELANNON, MISSISSIPPI 38868 county well located

LANDOWNER: Larry Gentry
Route 3
Blue Springs, Miss 38828
(mailing address)

description of formations encountered	from	to
<u>surface sand & clay</u>	<u>0</u>	<u>16</u>
<u>Blue clay</u>	<u>16</u>	<u>160</u>
<u>Sand</u>	<u>160</u>	<u>322</u>
<u>Bottom</u>	<u>322</u>	

WELL LOCATION:
sec. 32 T. 7 N. R. 5 E. S. 5
2 1/2 miles E of Fairfield
(distance) (direction) (nearest town)

WELL PURPOSE: home
(home, irrigation, municipal, industrial)

- WELL COMPLETION DATA:
- (1) diameter (inches) 5"
 - (2) total depth (feet) 300'
 - (3) static water level (feet) 50 below above top of ground.
 - (4) casing Steel, 21' (material), (depth)
5" (size) if telescope see back.
 - (5) screen no (length) (depth to top)
(size) (material)
 - (6) pump 1/2 (HP) 5 (yield gpm)
electric (type power)
 - (7) electric log no (yes or no)
(organization running log)
 - (8) how well bottom plugged open

CODED


NOV 10 1971

DRILLERS REMARKS:

MISS. BD. OF
WATER COMM.

If well telescopes please sketch and show depths.

GROUND LEVEL

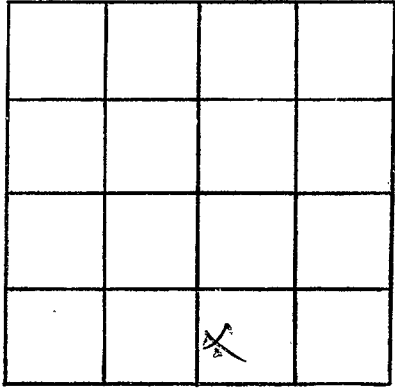

SECTION 32

Please indicate well location X.

ADDITIONAL INFORMATION

If more than one screen, show locations of each on sketch.