

J31
4-4-62

WATER WELL DRILLERS LOG

CODED

Date: 4-4, 1962, Driller: J. L. ... County: Union
(Name)

(1) Owner of Land: D. H. Yates
(Name)
Blue Springs R2D3
(Address)

(2) Location: NE 1/4, NW 1/4, Sec. 29, T7R6
6 miles north of Blue Springs
(distance) (direction) (Nearest Town)

(3) Topography: V
(Hilly) (Flat) (Level)

(4) Purpose of Well: Domestic
(Domestic Irrigation
Municipal, Industrial, Other)

Description & Color of Materials Sand, Clay, Red Clay, Shell, etc.	Thick- ness Feet	Depth Feet
<u>25 Blue clay</u>	<u>15</u>	<u>15</u>
<u>sand</u>	<u>10</u>	<u>25</u>
<u>Blue marl</u>	<u>200</u>	<u>225</u>
<u>marl + blue</u>		
<u>marl</u>	<u>100</u>	<u>330</u>

Information upon completion of well:

(1) Diameter 4 inches.

(2) Total Depth 330 feet.

(3) Water Level 82 feet below top of ground.

(4) Cased to 42, Size _____

(5) Screen: Size _____, Length _____


(6) Were any formations sealed against pollution?
_____ yes, _____ no.

If YES depth of formation _____

Why _____

Drillers Remarks: _____

CODED

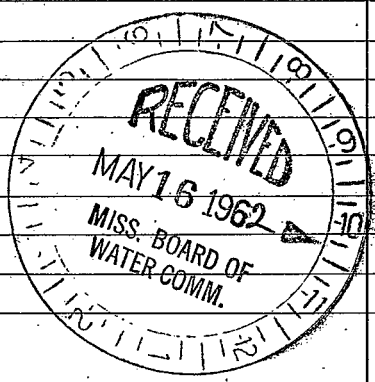

(Use Back Side)

Well No.

.....

.....

