

Union
J 34
11/66

MISSISSIPPI BOARD OF WATER COMMISSIONERS

WATER WELL DRILLERS LOG

CODED

Date: 11-26, 1966, Driller: CFCARLISE County VIVION
(Name)

(1) Owner of Land: ML ARMSTRONG
(Name)
BLUE SPRING MISSRI
(Address)

(2) Location: NW 1/4, NE 1/4, Sec. 6 T7R4
8 miles EAST of N.A.
(distance) (direction) (Nearest Town)

(3) Topography: X
(Hilly) (Flat) (Level)

(4) Purpose of Well: DOMESTIC
(Domestic Irrigation
Municipal, Industrial, Other)

Description & Color of Materials Sand, Clay, Red Clay, Shell, etc.	Thick- ness Feet	Depth Feet
<u>RED CLAY</u>	<u>23</u>	<u>25'</u>
<u>ROCK</u>	<u>43</u>	<u>70</u>
<u>BLUE DIRT</u>	<u>230</u>	<u>300</u>
<u>CHALK</u>	<u>200</u>	<u>500</u>
<u>W ROCK</u>	<u>7</u>	<u>507</u>
<u>WATERSAND</u>	<u>42</u>	<u>549</u>

Information upon completion of well:

(1) Diameter 4 inches.

(2) Total Depth 549 feet.

(3) Water Level 90 feet below top of ground.

(4) Cased to 87, Size 4 in.

(5) Screen: Size NONE Length ---.


(6) Were any formations sealed against pollution?
--- yes, X no.

If YES depth of formation ---

Why ---

Drillers Remarks: ---

CODED

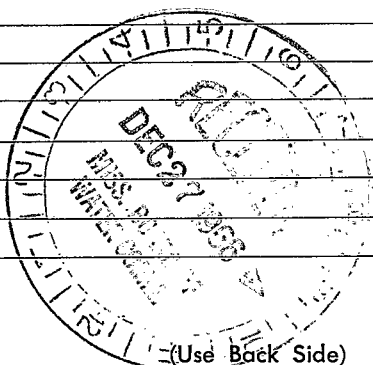

117

Well No.

