

MISSISSIPPI
BOARD OF WATER COMMISSIONERS
416 North State Street
Jackson, Mississippi 39201

WATER WELL DRILLERS LOG

CODED

8-28 1968 Ed Clark Cos. Union
date well completed firm name county well located

LANDOWNER:

Ray Cooke

New Albany, Rt
(mailing address)

WELL LOCATION:

sec 5 T 7 N R 4 E
S W
8 miles E of New Albany
(distance) (direction) (nearest town)

WELL PURPOSE:

Home
(home, irrigation, municipal, industrial)

WELL COMPLETION DATA:

- (1) diameter (inches) 4"
- (2) total depth (feet) 680'
- (3) static water level (feet) 110' below top of ground.
- (4) casing Metal, 126',
(material) (depth)
4" If telescope see back.
(size)
- (5) screen none
(length) (depth to top)
- (size) (material)
- (6) pump 3/4 Rod 4
(HP) (yield gpm)
Electric
(type power)
- (7) electric log no
(yes or no)
- (organization running log)
- (8) how well bottom plugged no


DRILLERS REMARKS:

description of formations encountered

from to


Clay	0	20
Rock & Sand	20	60
Blue Mud	60	595
Rock & Sand	595	680

CODED

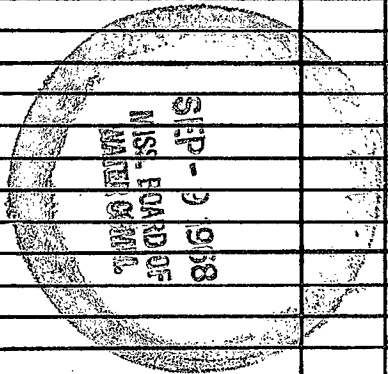

If well telescopes please sketch and show depths.

GROUND LEVEL

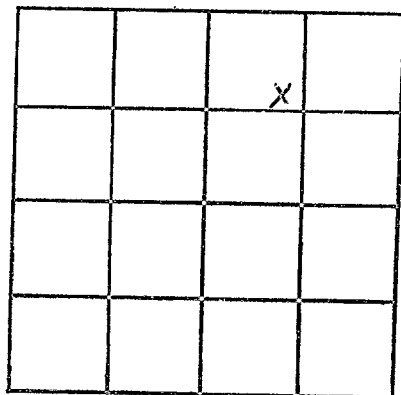

SECTION _____

Please indicate well location X.

ADDITIONAL INFORMATION

If more than one screen,
show locations of each on sketch.