

UNION
J 38
 MISS. BD. OF
 WATER CC.
1-19-72
 619

MISSISSIPPI
 BOARD OF WATER COMMISSIONERS
 416 North State Street
 Jackson, Mississippi 39201

614.00
 37.00
 00

WATER WELL DRILLERS LOG

CODED
 Lemmer

19 72 date well completed J T Medlin firm name Lemmer county well located

LANDOWNER: Tom Hunt Cole
New Albany
 (mailing address)

description of formations encountered	from	to
Red clay	0	27
R. clay	27	65
sand	65	85
Blue	85	200

WELL LOCATION:
 sec. 2 T 2 N R 40 E
4 miles S.E. of Keosauqua
 (distance) (direction) (nearest town)

WELL PURPOSE:
 (home, irrigation, municipal, industrial)

WELL COMPLETION DATA:

(1) diameter (inches) 4

(2) total depth (feet) 140

(3) static water level (feet) 62 below above top of ground.

(4) casing P 100
 (material) (depth)
 (size) if telescope see back.

(5) screen 10 90
 (length) (depth to top)
4 P
 (size) (material)

(6) pump 3/4 4
 (HP) (yield gpm)
E
 (type power)

(7) electric log (yes or no) _____
 (organization running log) _____


(8) how well bottom plugged cap

CODED

DRILLERS REMARKS:

If well telescopes please sketch and show depths.

GROUND LEVEL

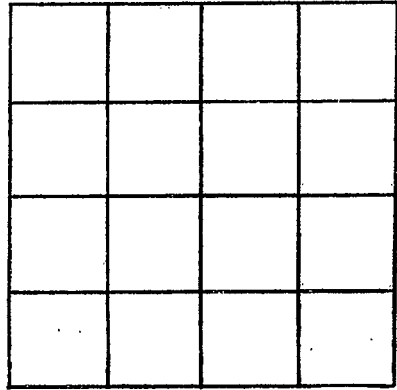

SECTION _____

Please indicate well location X.

ADDITIONAL INFORMATION

If more than one screen, show locations of each on sketch.