

MISSISSIPPI
BOARD OF WATER COMMISSIONERS
416 North State Street
Jackson, Mississippi 39201

CODED

WATER WELL DRILLERS LOG

Union
J 39
5-19-72

May 19 1972 J.W. Wellborn Union
date well completed firm name county well located

LANDOWNER: <u>Jerry Carter</u>	description of formations encountered	from	to
<u>Blue Springs</u> (mailing address)	<u>Soil</u>	<u>0</u>	<u>1</u>
	<u>Sand + Clay</u>	<u>1</u>	<u>19</u>
	<u>Blue Rock</u>	<u>19</u>	<u>214</u>
	<u>Water Rock</u>	<u>214</u>	<u>215</u>
	<u>Water Sand</u>	<u>215</u>	<u>345</u>
	<u>Coffee Sand</u>		


CODED

JUN 10 1972

MISS. BU. OF
MINES
MEMBERS COUNCIL

If well telescopes please sketch and show depths.

GROUND LEVEL

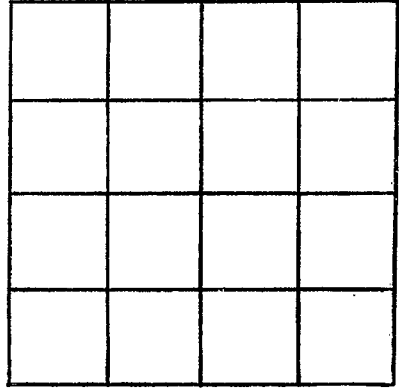

SECTION _____

Please indicate well location X.

ADDITIONAL INFORMATION

If more than one screen, show locations of each on sketch.