

✓ 42
 UNION
 7-13-73
 7-13 1973

MISSISSIPPI
 BOARD OF WATER COMMISSIONERS
 416 North State Street
 Jackson, Mississippi 39201

900 00
 + 5 00
 945 60

WATER WELL DRILLERS LOG

CODED

JT Medlin

Union

date well completed

firm name

county well located

LANDOWNER:
 Walter Knight
 New Albany
 (mailing address)

description of formations encountered	from	to
Clay	0	30
blue "x" rock	30	120
rock 100 R ₄ sand	120	212

WELL LOCATION:
 sec. 18 T 7 R 3 E
 S W
 1 miles N of Centon
 (distance) (direction) (nearest town)

CODED

WELL PURPOSE:
 (home, irrigation, municipal, industrial)

WELL COMPLETION DATA:


- (1) diameter (inches) 4
- (2) total depth (feet) 212
- (3) static water level (feet) 20 below above top of ground.
- (4) casing P 120
(material) (depth)
if telescope see back.
(size)
- (5) screen Ø
(length) (depth to top)
(size) (material)
- (6) pump 1 5
(HP) (yield gpm)
E
(type power)
- (7) electric log
(yes or no)
(organization running log)
- (8) how well bottom plugged

AUG 22 1973

DRILLERS REMARKS:

If well telescopes please
sketch and show depths.

GROUND LEVEL

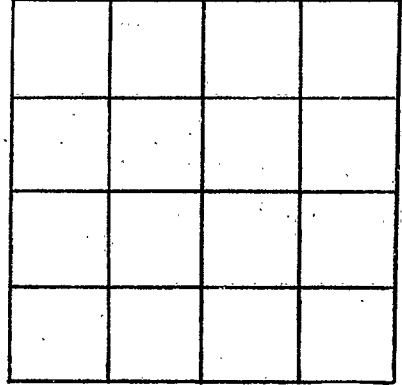

SECTION _____

Please indicate well location X.

ADDITIONAL INFORMATION

If more than one screen,
show locations of each on sketch.